



Theta Chi of Penn State
2020 House Plan Set

| No. | Description | Date |
|-----|-------------|------|
| | | |
| | | |
| | | |
| | | |

| Elevation - Front | | E001 |
|-------------------|-------------|------|
| Project number | ECO620 | |
| Date | 05/06/2020 | |
| Drawn by | A. SPEAGLE | |
| Checked by | A. SCHREYER | |
| Scale 1" = 10'-0" | | |




① North
1" = 10'-0"



Theta Chi of Penn State 2020 House Plan Set

| No. | Description | Date |
|-----|-------------|------|
| | | |
| | | |
| | | |
| | | |

| Elevation - Back | | E002 |
|-------------------|-------------|------|
| Project number | ECO620 | |
| Date | 05/06/2020 | |
| Drawn by | A. SPEAGLE | |
| Checked by | A. SCHREYER | |
| Scale 1" = 10'-0" | | |

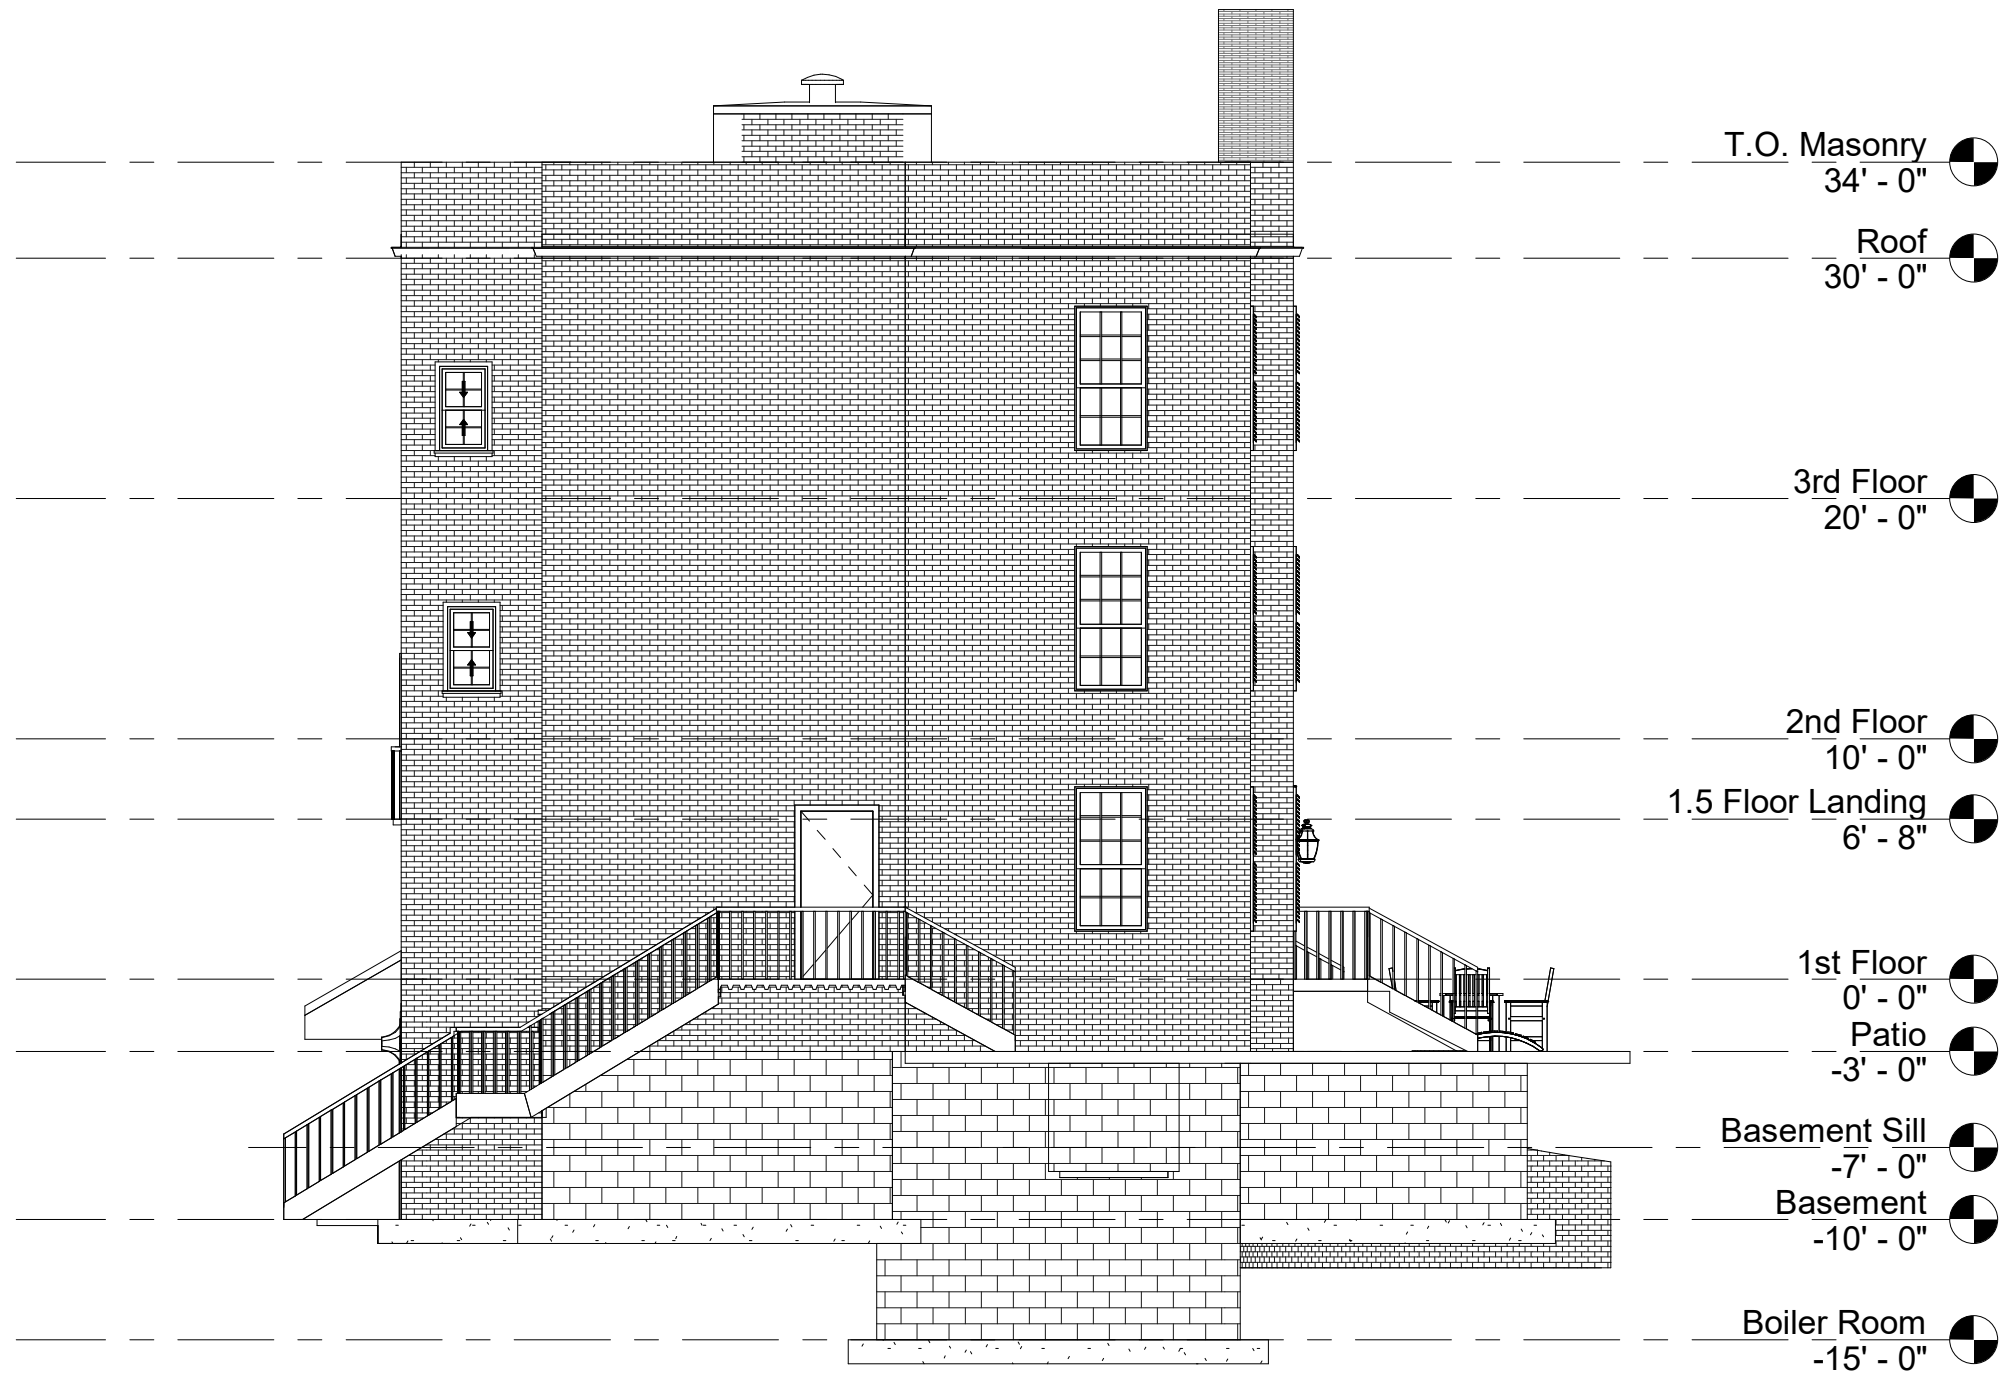

① West
1/8" = 1'-0"




Theta Chi of Penn State 2020 House Plan Set

| No. | Description | Date |
|-----|-------------|------|
| | | |
| | | |
| | | |
| | | |

Elevation - West

| | | |
|----------------|-------------|--------------|
| Project number | ECO620 | E003 |
| Date | 05/06/2020 | |
| Drawn by | A. SPEAGLE | |
| Checked by | A. SCHREYER | |
| Scale | | 1/8" = 1'-0" |

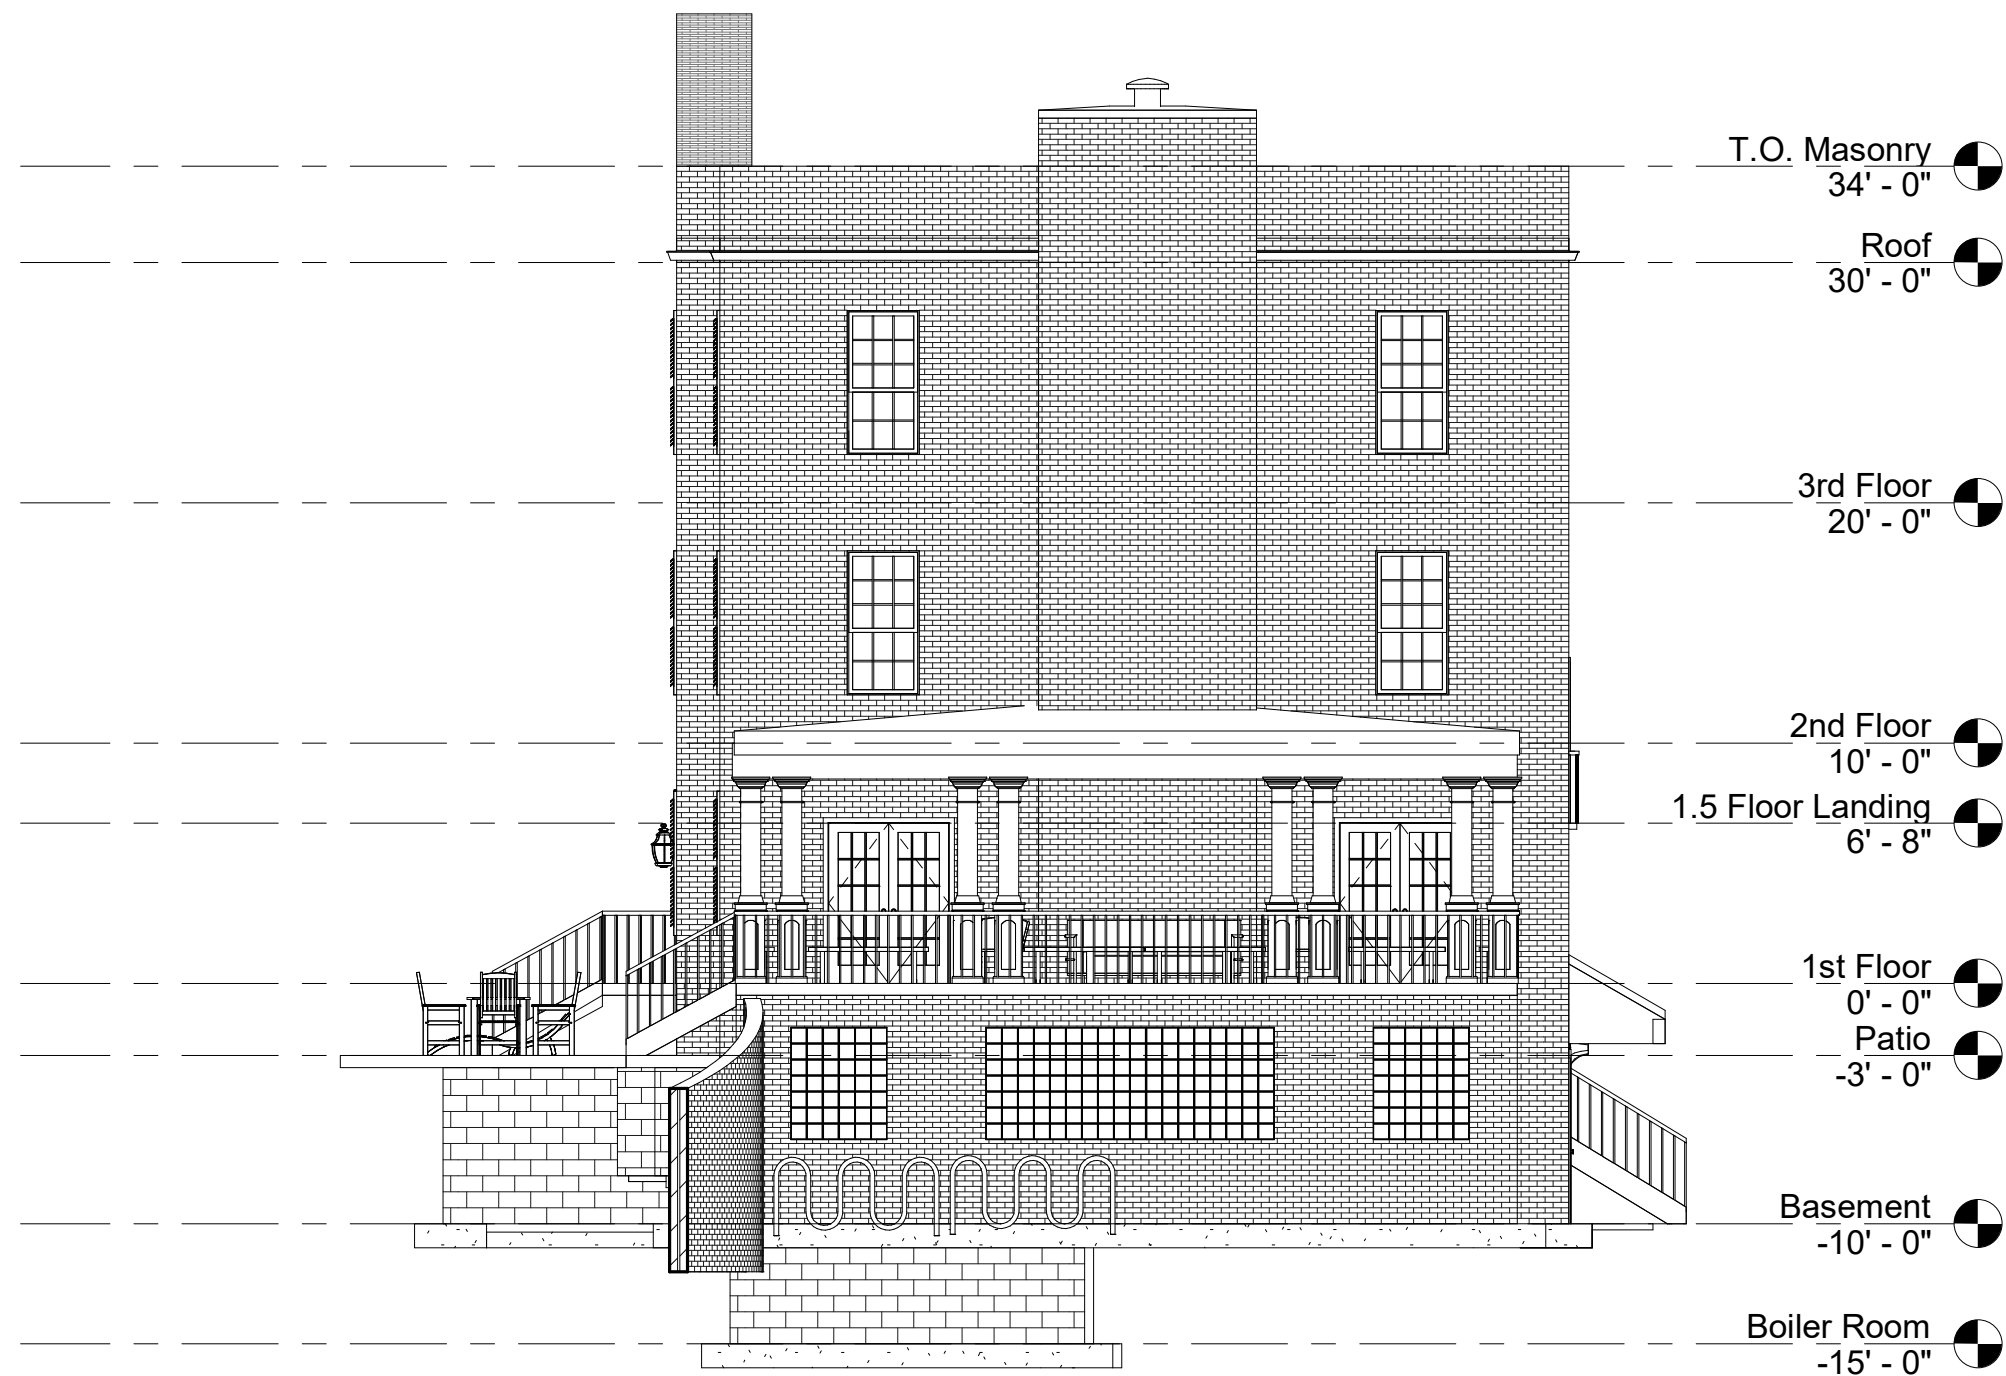


① East
1/8" = 1'-0"



Theta Chi of Penn State 2020 House Plan Set

| No. | Description | Date |
|-----|-------------|------|
| | | |
| | | |
| | | |
| | | |

| Elevation - East | | |
|------------------|-------------|---------------|
| Project number | ECO620 | <h1>E004</h1> |
| Date | 05/06/2020 | |
| Drawn by | A. SPEAGLE | |
| Checked by | A. SCHREYER | |
| Scale | | 1/8" = 1'-0" |

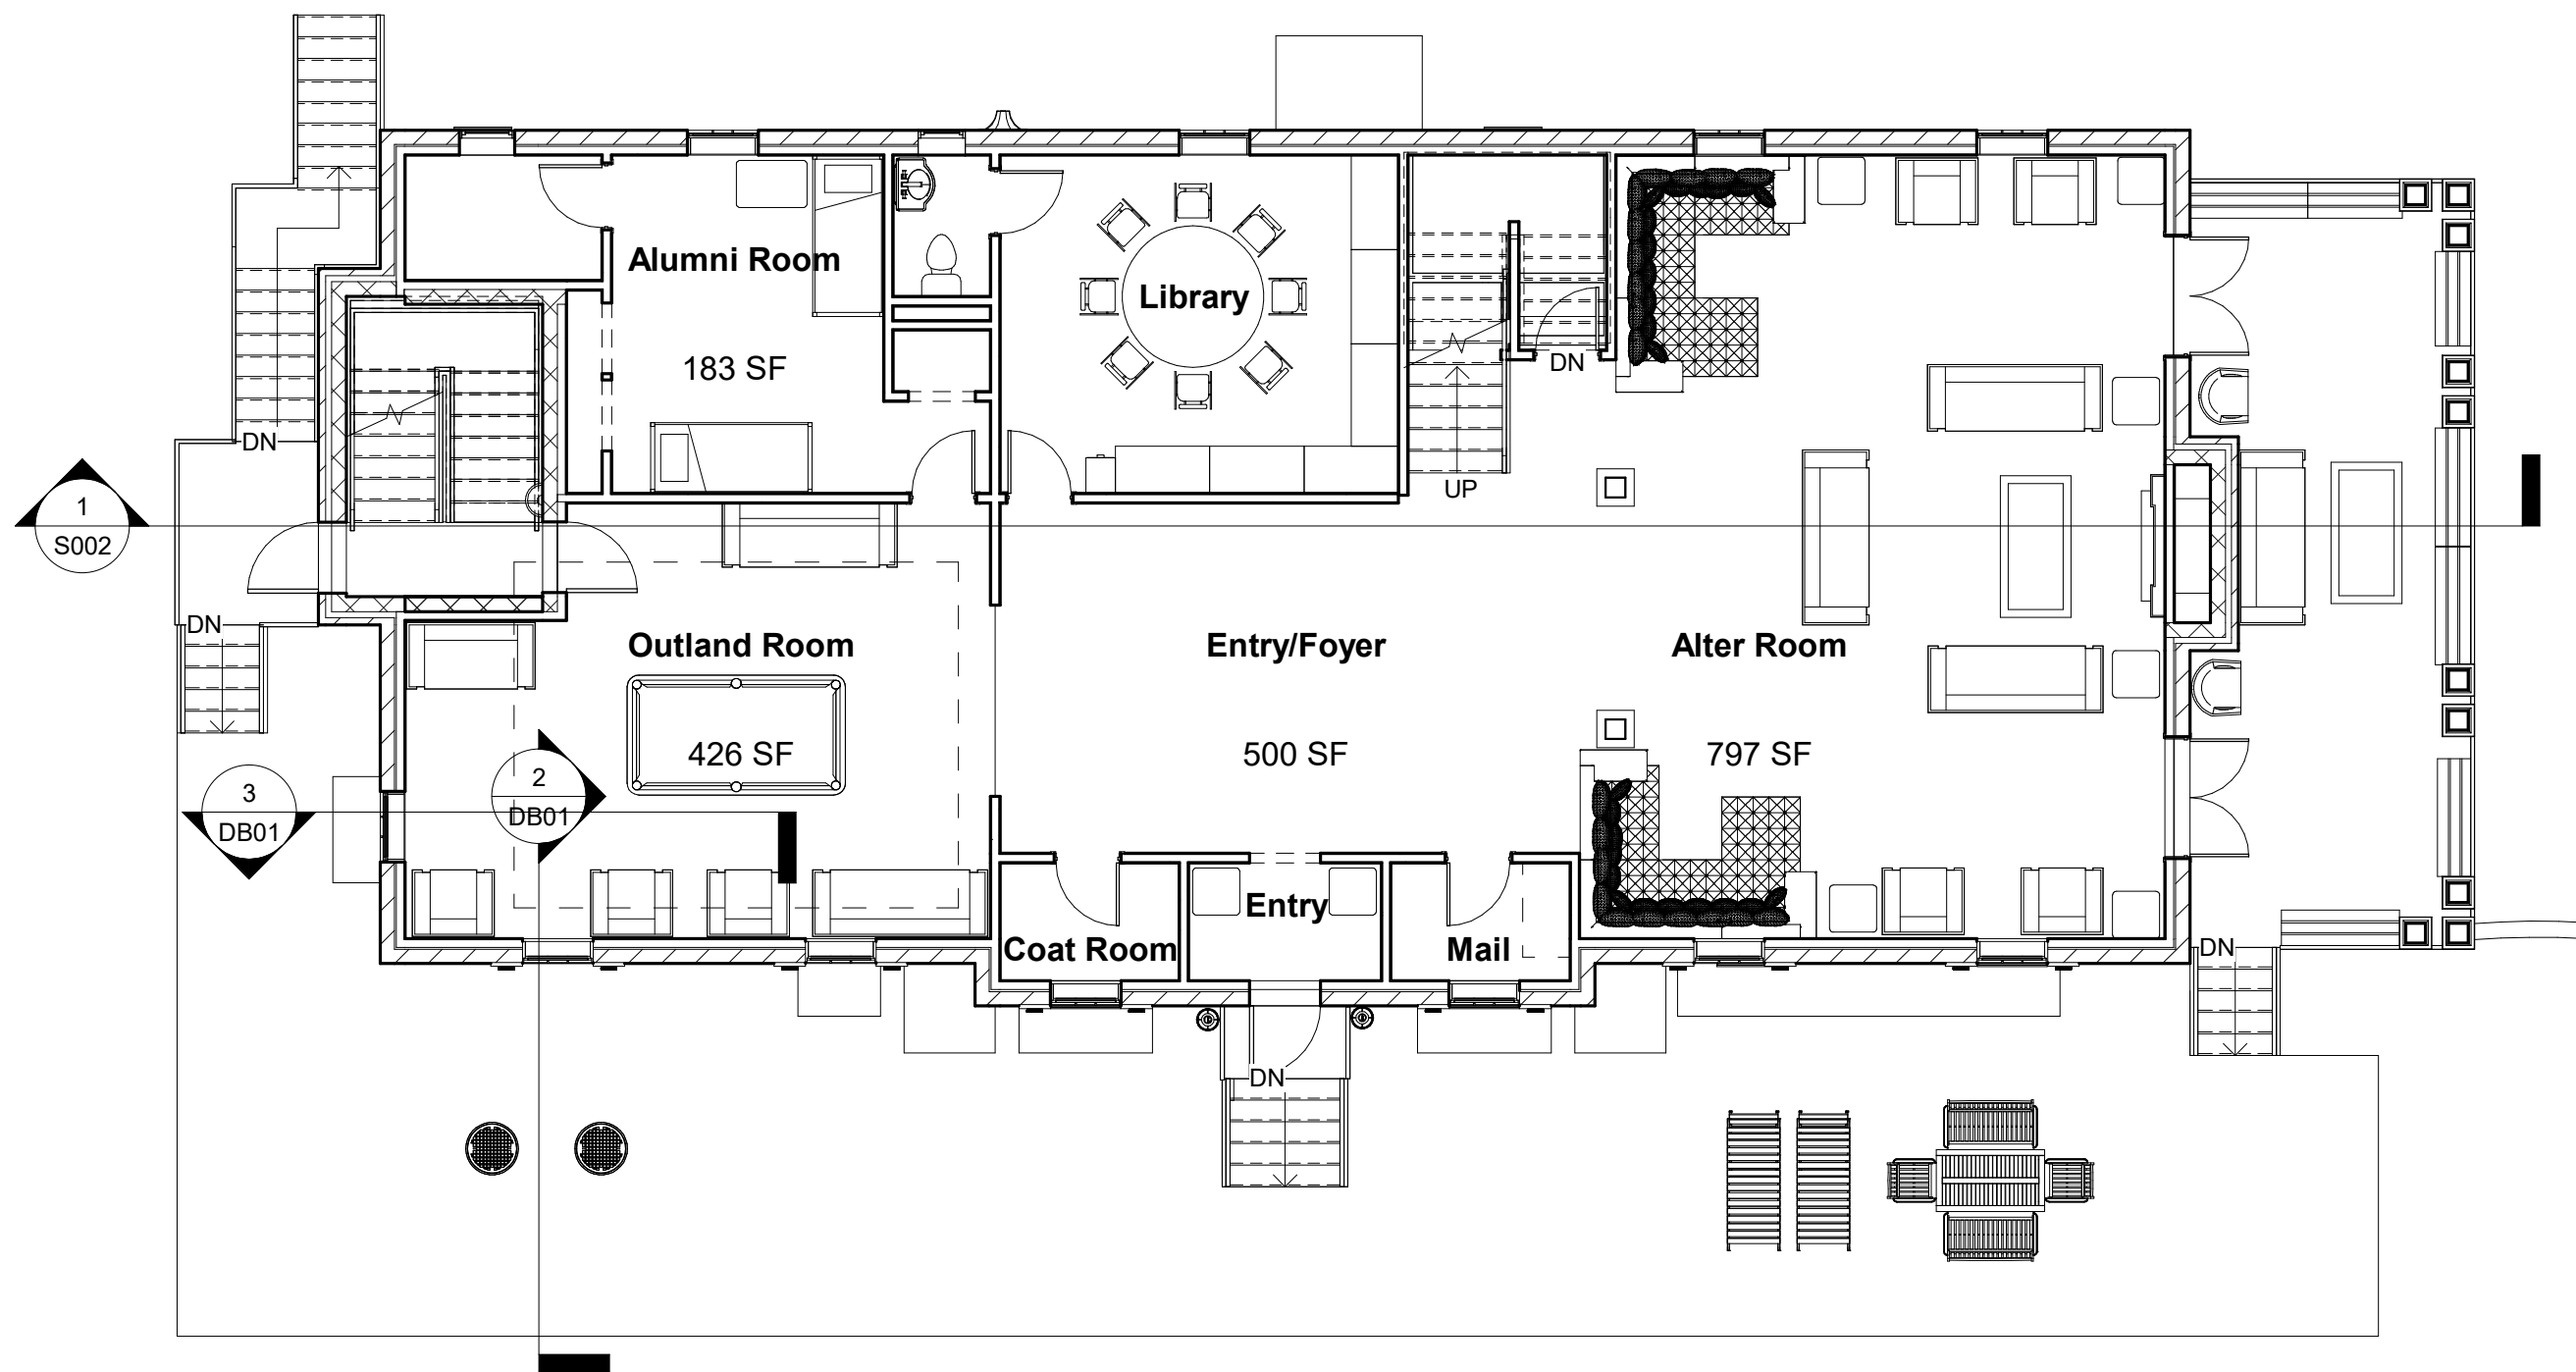

1 1st Floor
1/8" = 1'-0"



Theta Chi of Penn State 2020 House Plan Set


| No. | Description | Date |
|-----|-------------|------|
| | | |
| | | |
| | | |
| | | |

Plan - 1st Floor As-Built

Project number ECO620
Date 05/06/2020
Drawn by A. SPEAGLE
Checked by A. SCHREYER

P101

Scale 1/8" = 1'-0"

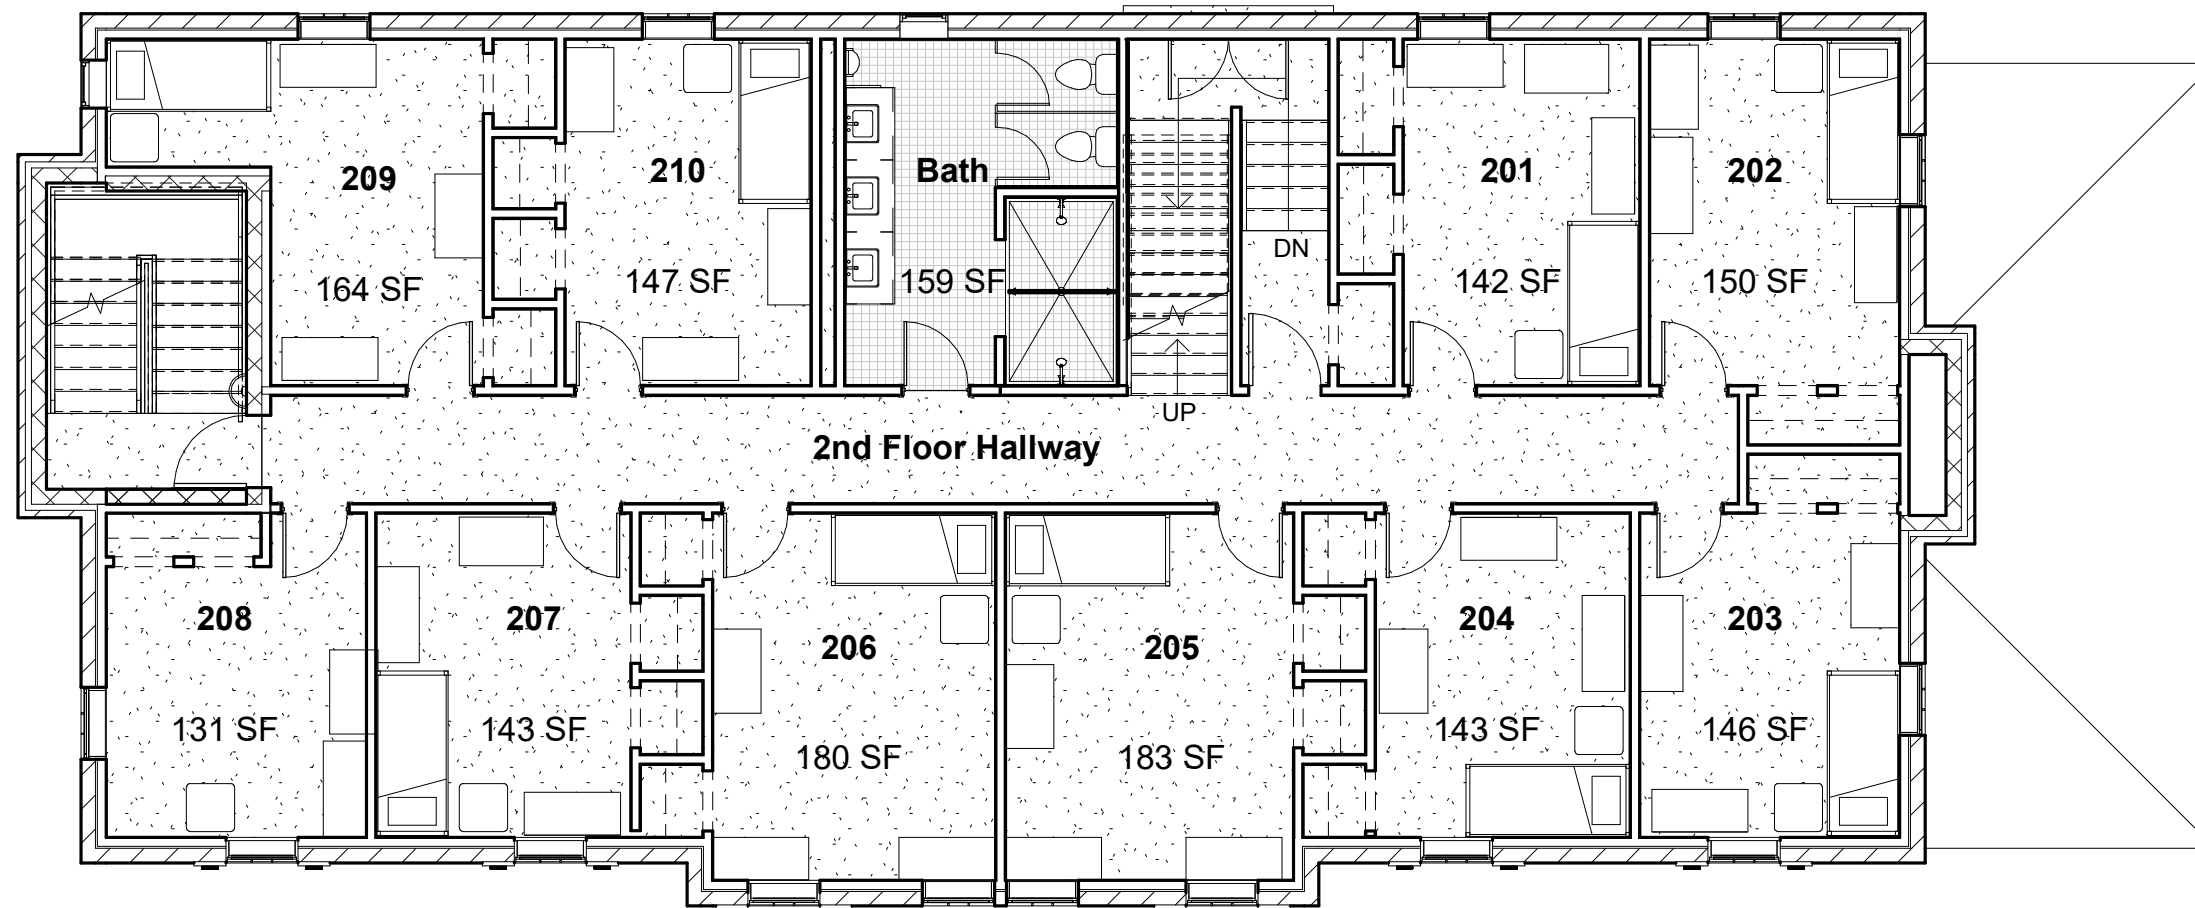


① 2nd Floor
1/8" = 1'-0"



Theta Chi of Penn State
2020 House Plan Set

| No. | Description | Date |
|-----|-------------|------|
| | | |
| | | |
| | | |
| | | |

| Plan - 2nd Floor As-Built | | P201 |
|---------------------------|-------------|--------------------|
| Project number | ECO620 | |
| Date | 05/06/2020 | |
| Drawn by | A. SPEAGLE | |
| Checked by | A. SCHREYER | Scale 1/8" = 1'-0" |

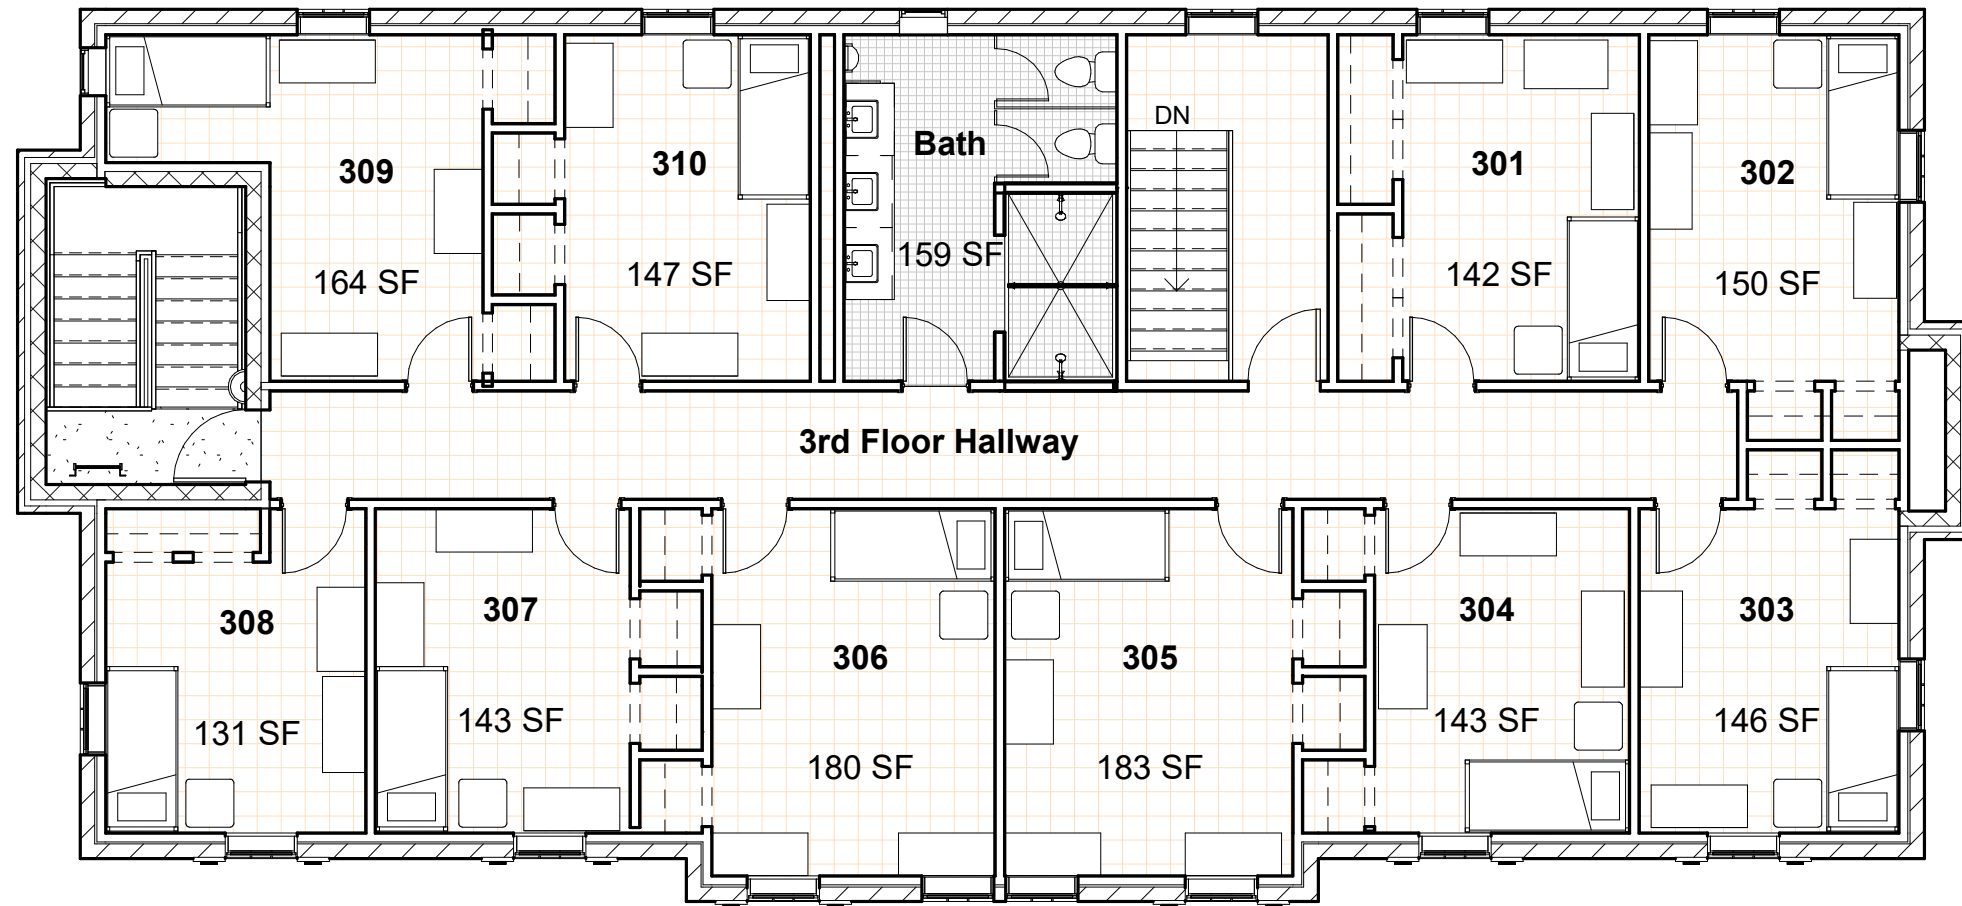

① 3rd Floor
1/8" = 1'-0"




Theta Chi of Penn State
2020 House Plan Set

| No. | Description | Date |
|-----|-------------|------|
| | | |
| | | |
| | | |
| | | |

Plan - 3rd Floor As-Built

| | |
|----------------|-------------|
| Project number | ECO620 |
| Date | 05/06/2020 |
| Drawn by | A. SPEAGLE |
| Checked by | A. SCHREYER |

P301
Scale 1/8" = 1'-0"

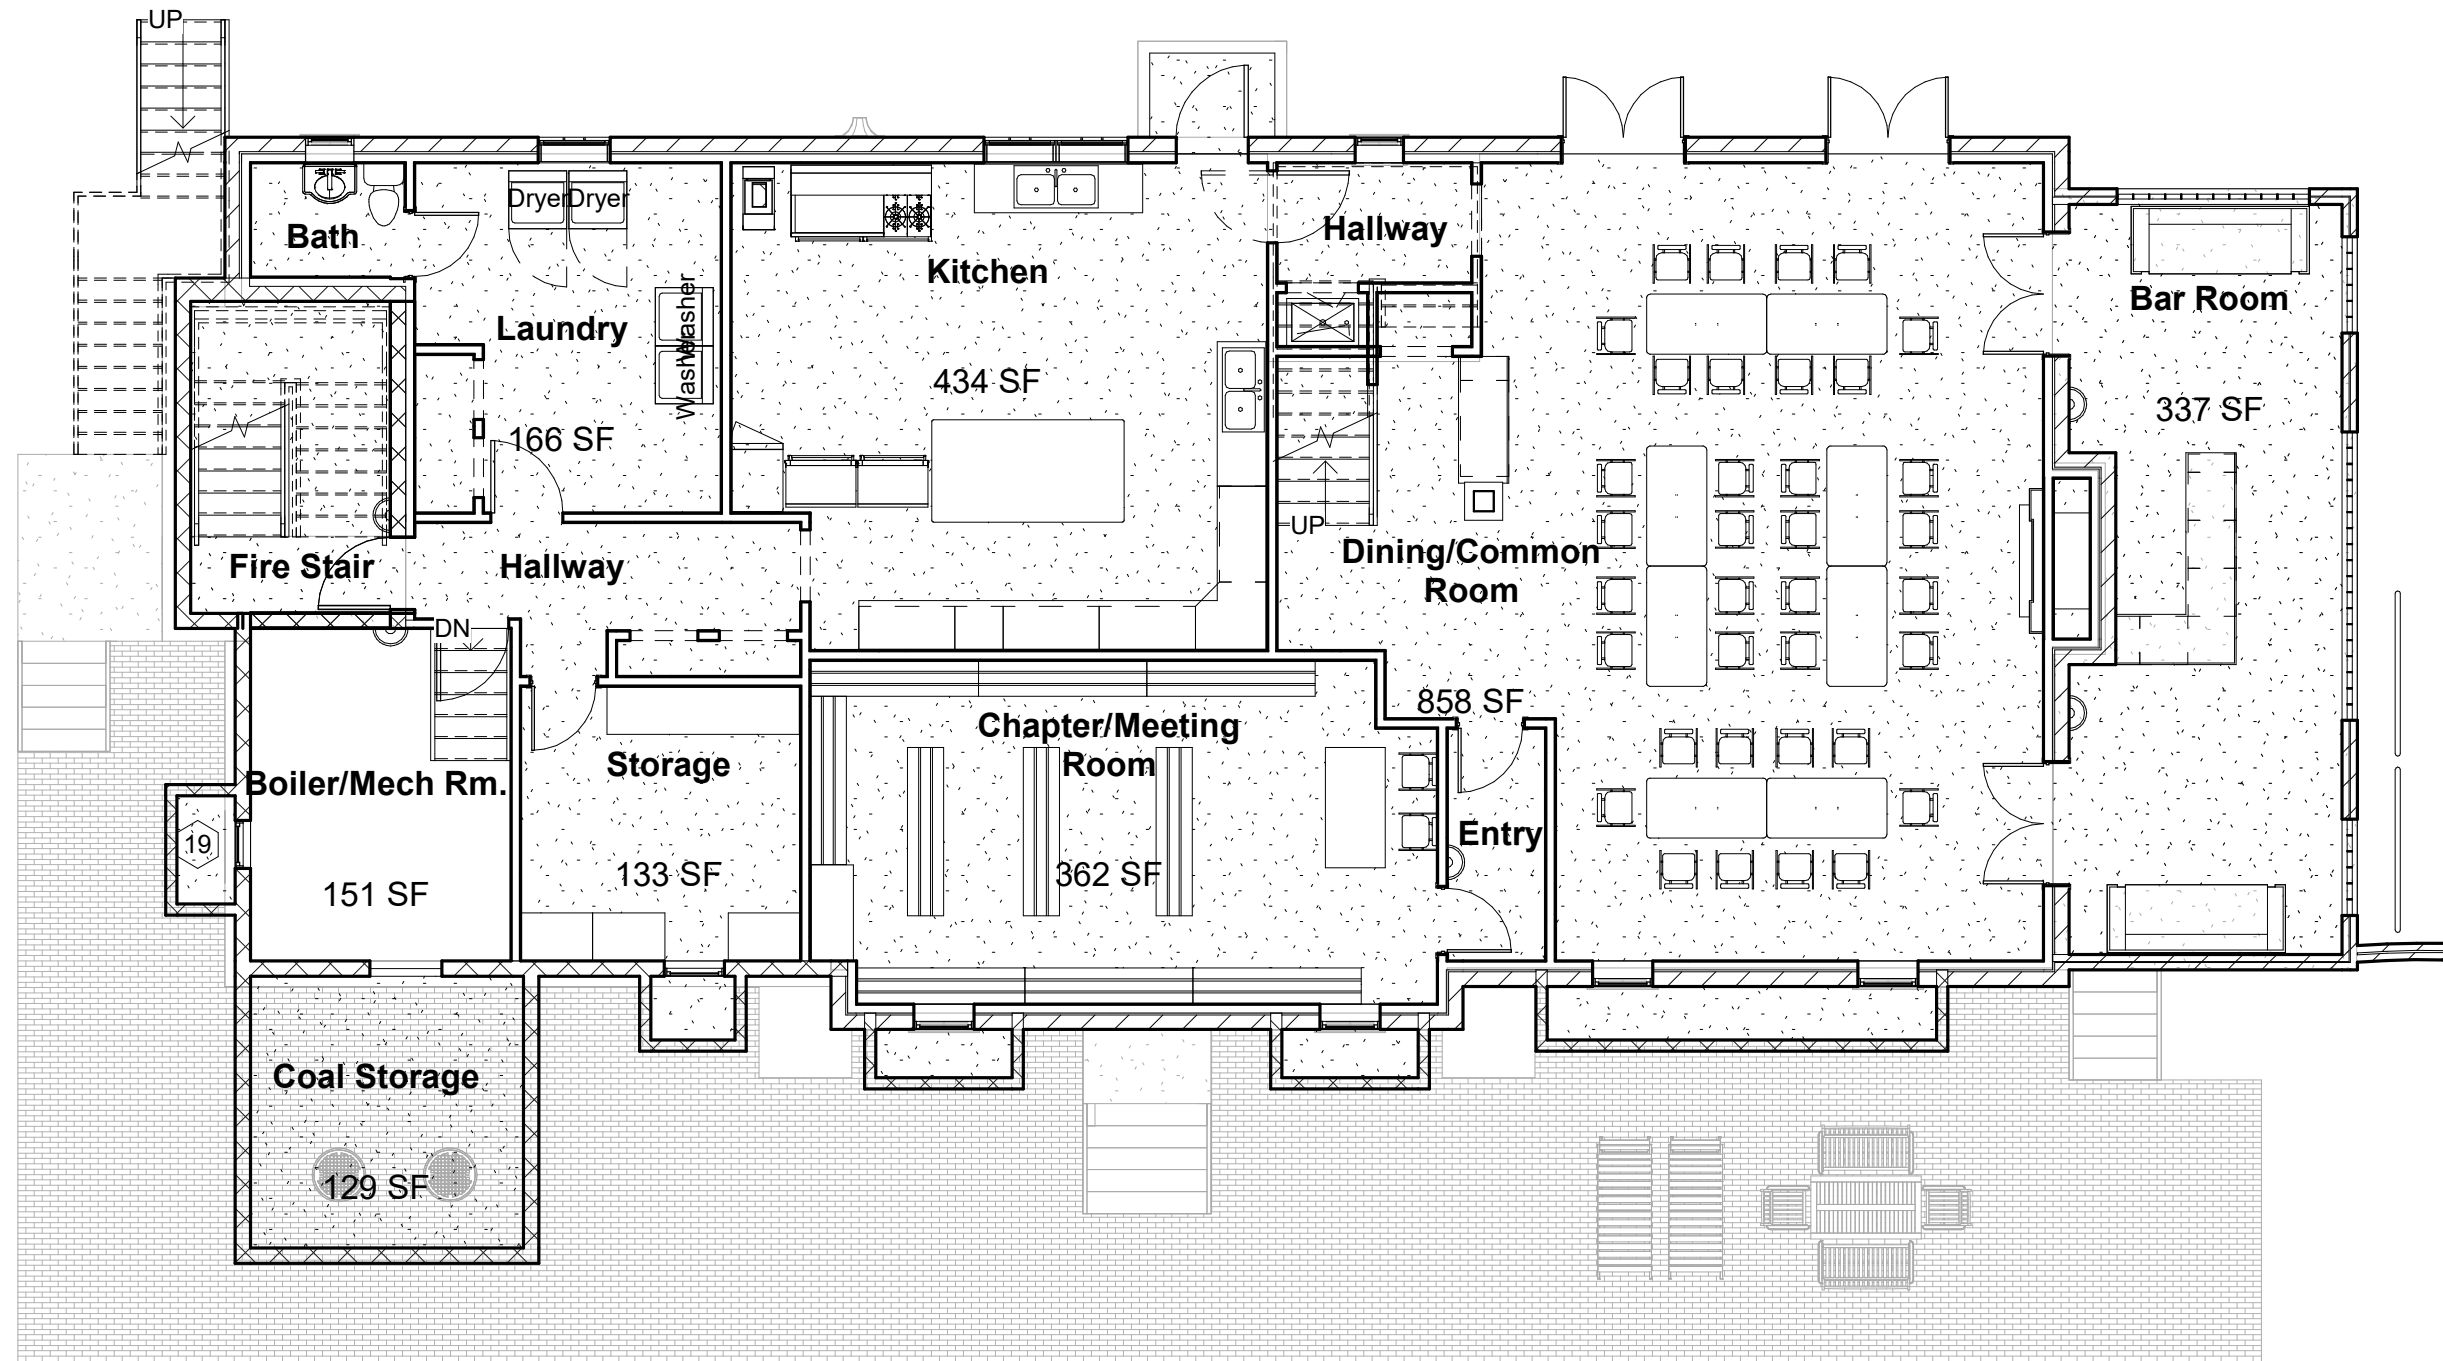

1 Basement
1/8" = 1'-0"



Theta Chi of Penn State 2020 House Plan Set


| No. | Description | Date |
|-----|-------------|------|
| | | |
| | | |
| | | |
| | | |

Plan - Basement As-Built

Project number ECO620
Date 05/06/2020
Drawn by A. SPEAGLE
Checked by A. SCHREYER

PB01

Scale 1/8" = 1'-0"

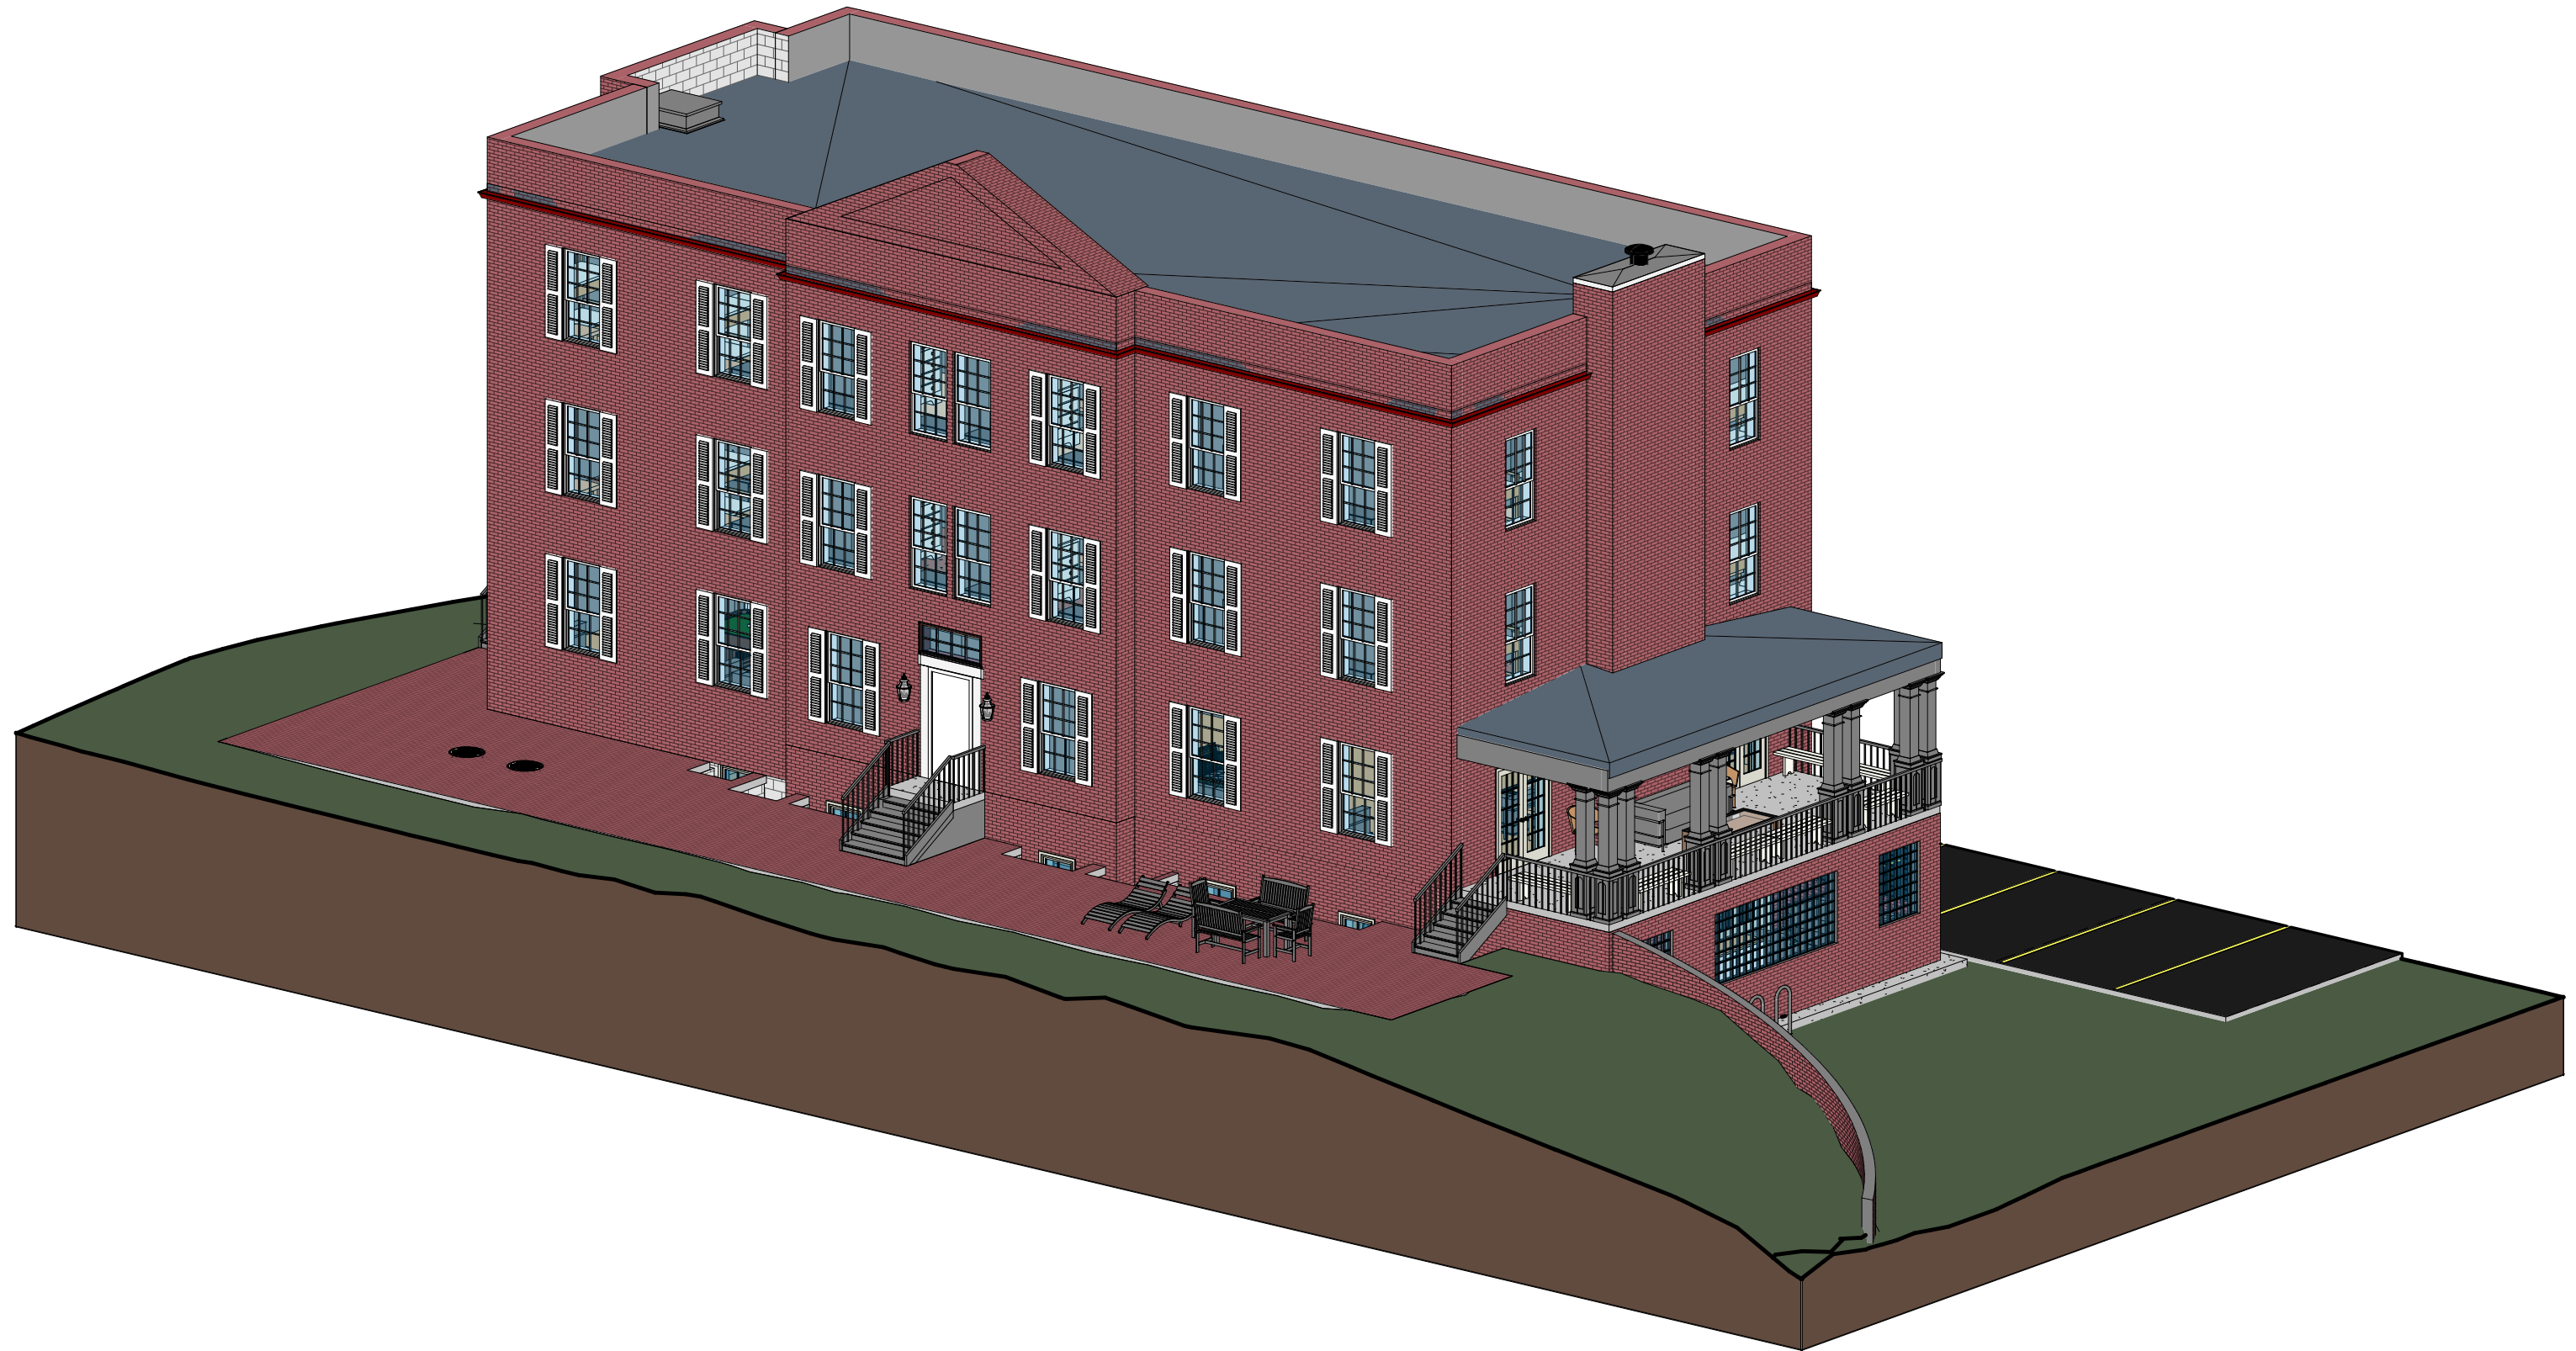

① 3D - South




Theta Chi of Penn State
2020 House Plan Set

| No. | Description | Date |
|-----|-------------|------|
| | | |
| | | |
| | | |
| | | |

3D - South Corner

| | | |
|----------------|-------------|-------------|
| Project number | ECO620 | R001 |
| Date | 05/06/2020 | |
| Drawn by | A. SPEAGLE | |
| Checked by | A. SCHREYER | |
| Scale | | |

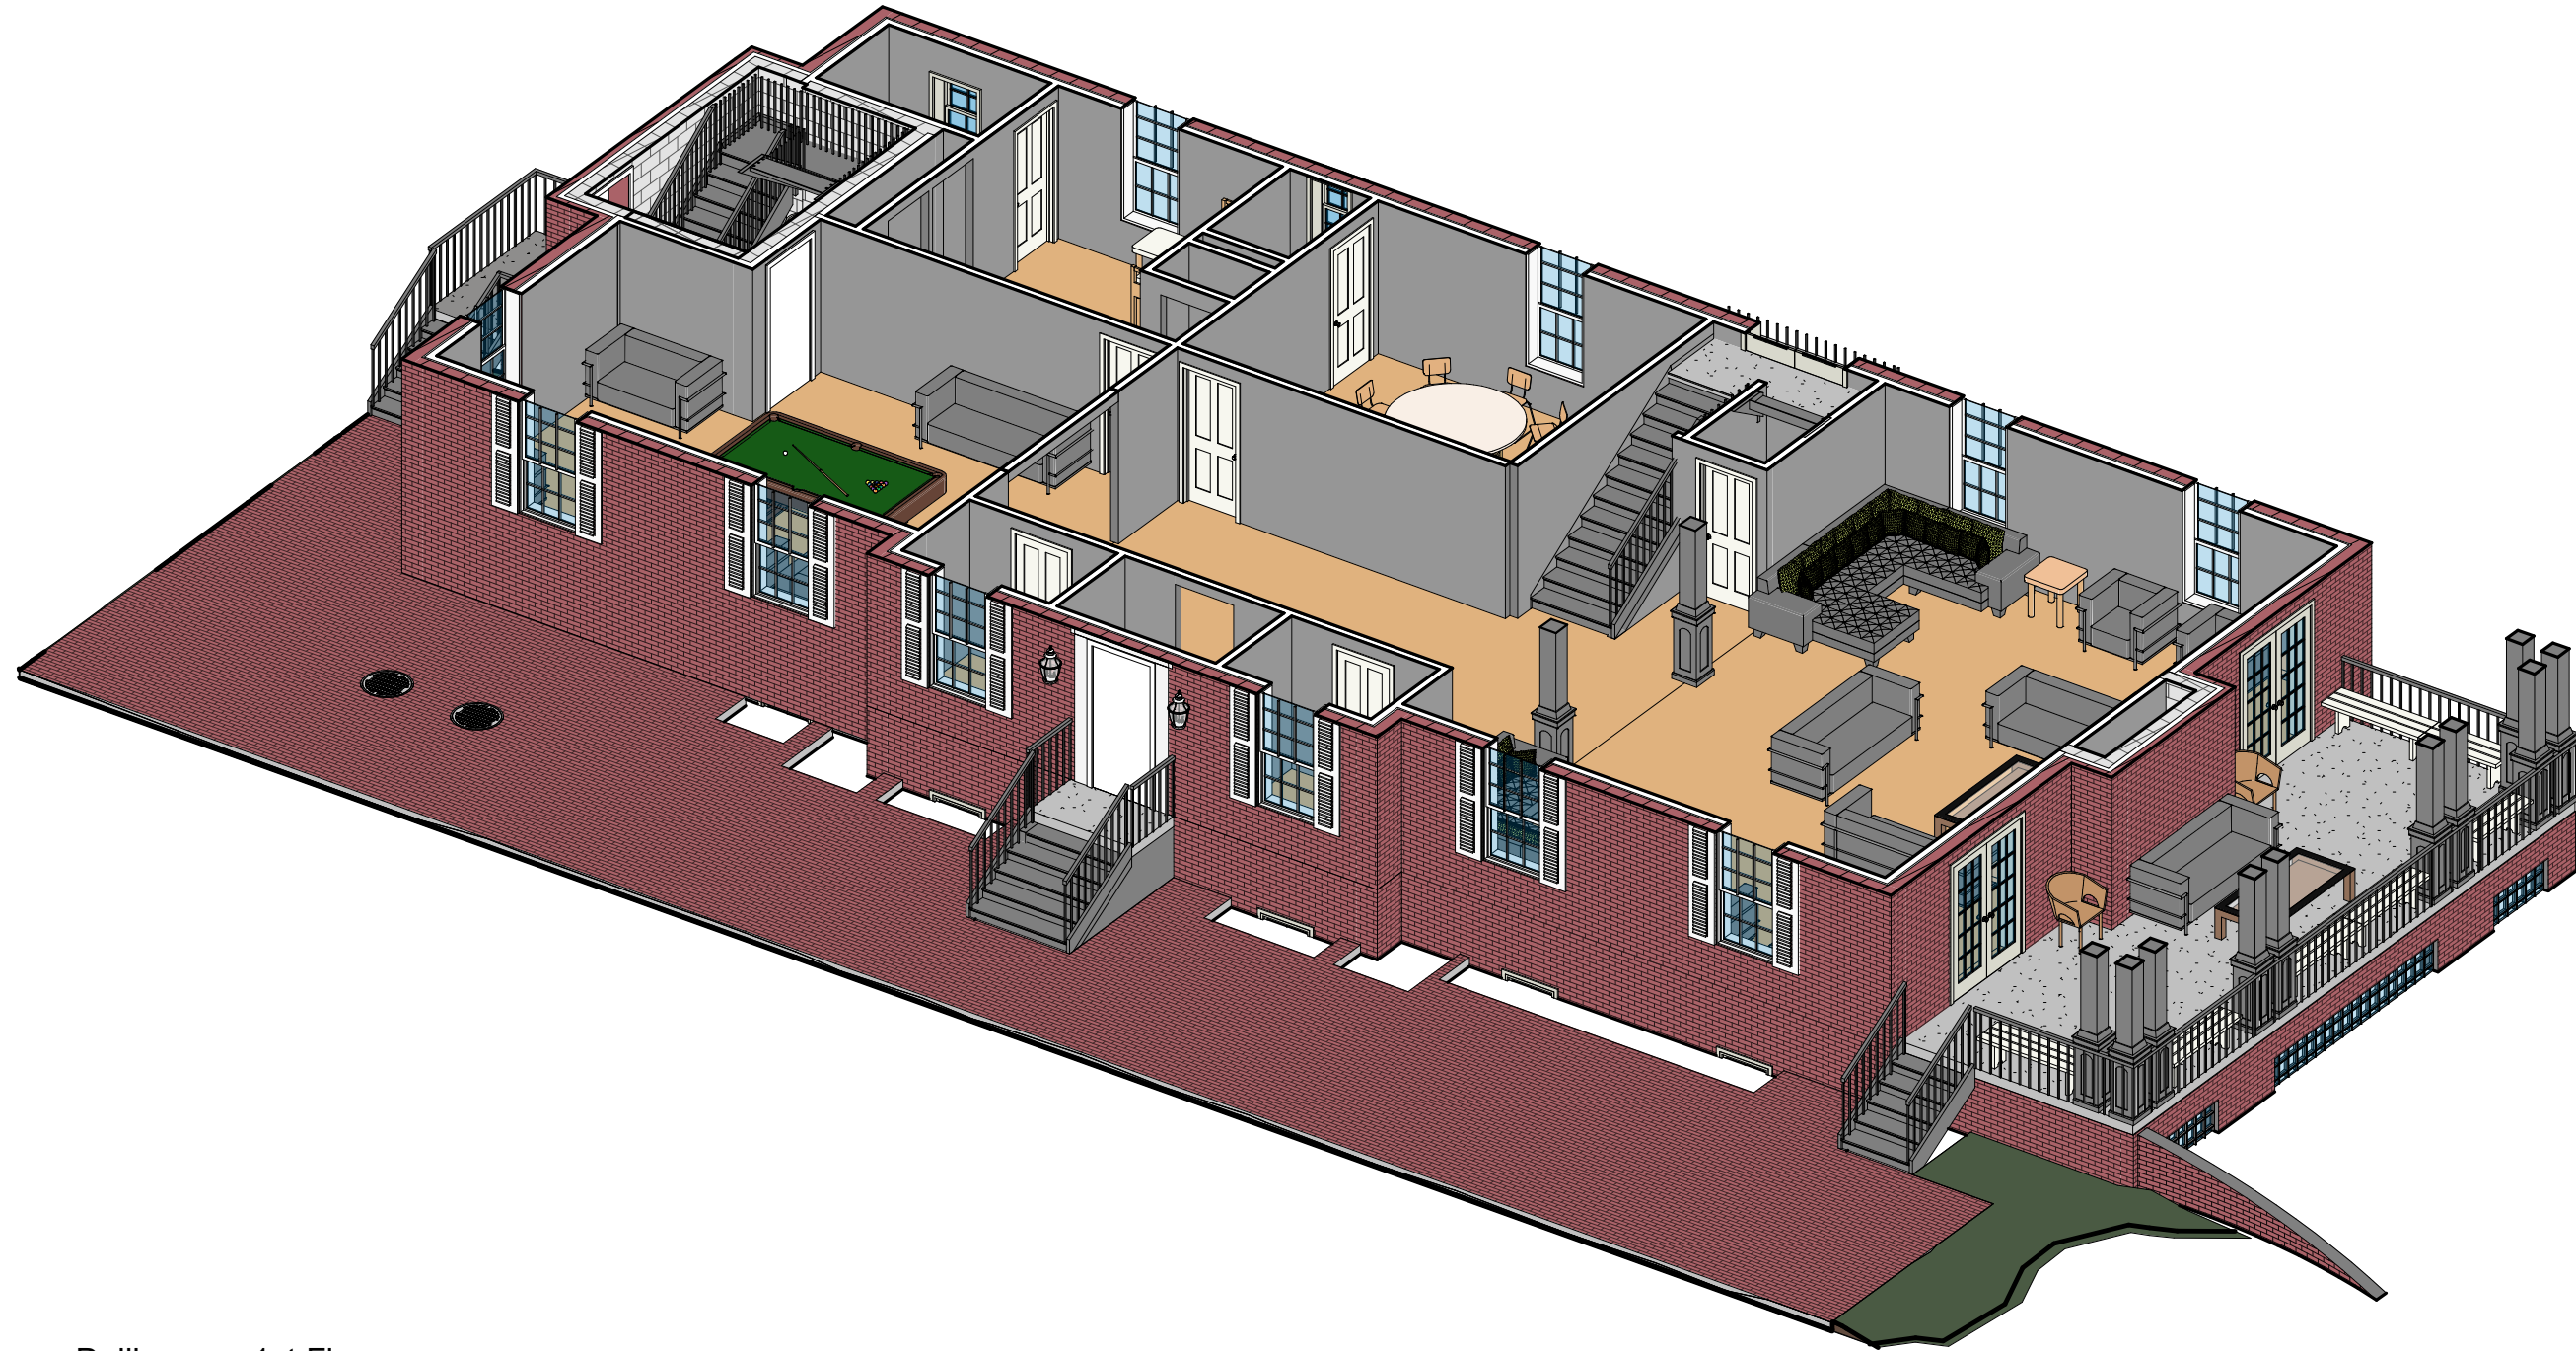

1 Dollhouse - 1st Floor



Theta Chi of Penn State
2020 House Plan Set

| No. | Description | Date |
|-----|-------------|------|
| | | |
| | | |
| | | |
| | | |

| Dollhouse - 1st Floor | | R101 |
|-----------------------|-------------|------|
| Project number | ECO620 | |
| Date | 05/06/2020 | |
| Drawn by | A. SPEAGLE | |
| Checked by | A. SCHREYER | |
| Scale | | |



1 Camera - Porch



Theta Chi of Penn State
2020 House Plan Set

| No. | Description | Date |
|-----|-------------|------|
| | | |
| | | |
| | | |
| | | |

Camera - Side Porch

| | | |
|----------------|-------------|-------------|
| Project number | ECO620 | R103 |
| Date | 05/06/2020 | |
| Drawn by | A. SPEAGLE | |
| Checked by | A. SCHREYER | |
| Scale | | |




① Camera - 1st floor stairs



Theta Chi of Penn State
2020 House Plan Set

| No. | Description | Date |
|-----|-------------|------|
| | | |
| | | |
| | | |
| | | |

| Camera - 1st Floor | | R104 |
|--------------------|-------------|-------|
| Project number | ECO620 | |
| Date | 05/06/2020 | |
| Drawn by | A. SPEAGLE | |
| Checked by | A. SCHREYER | Scale |

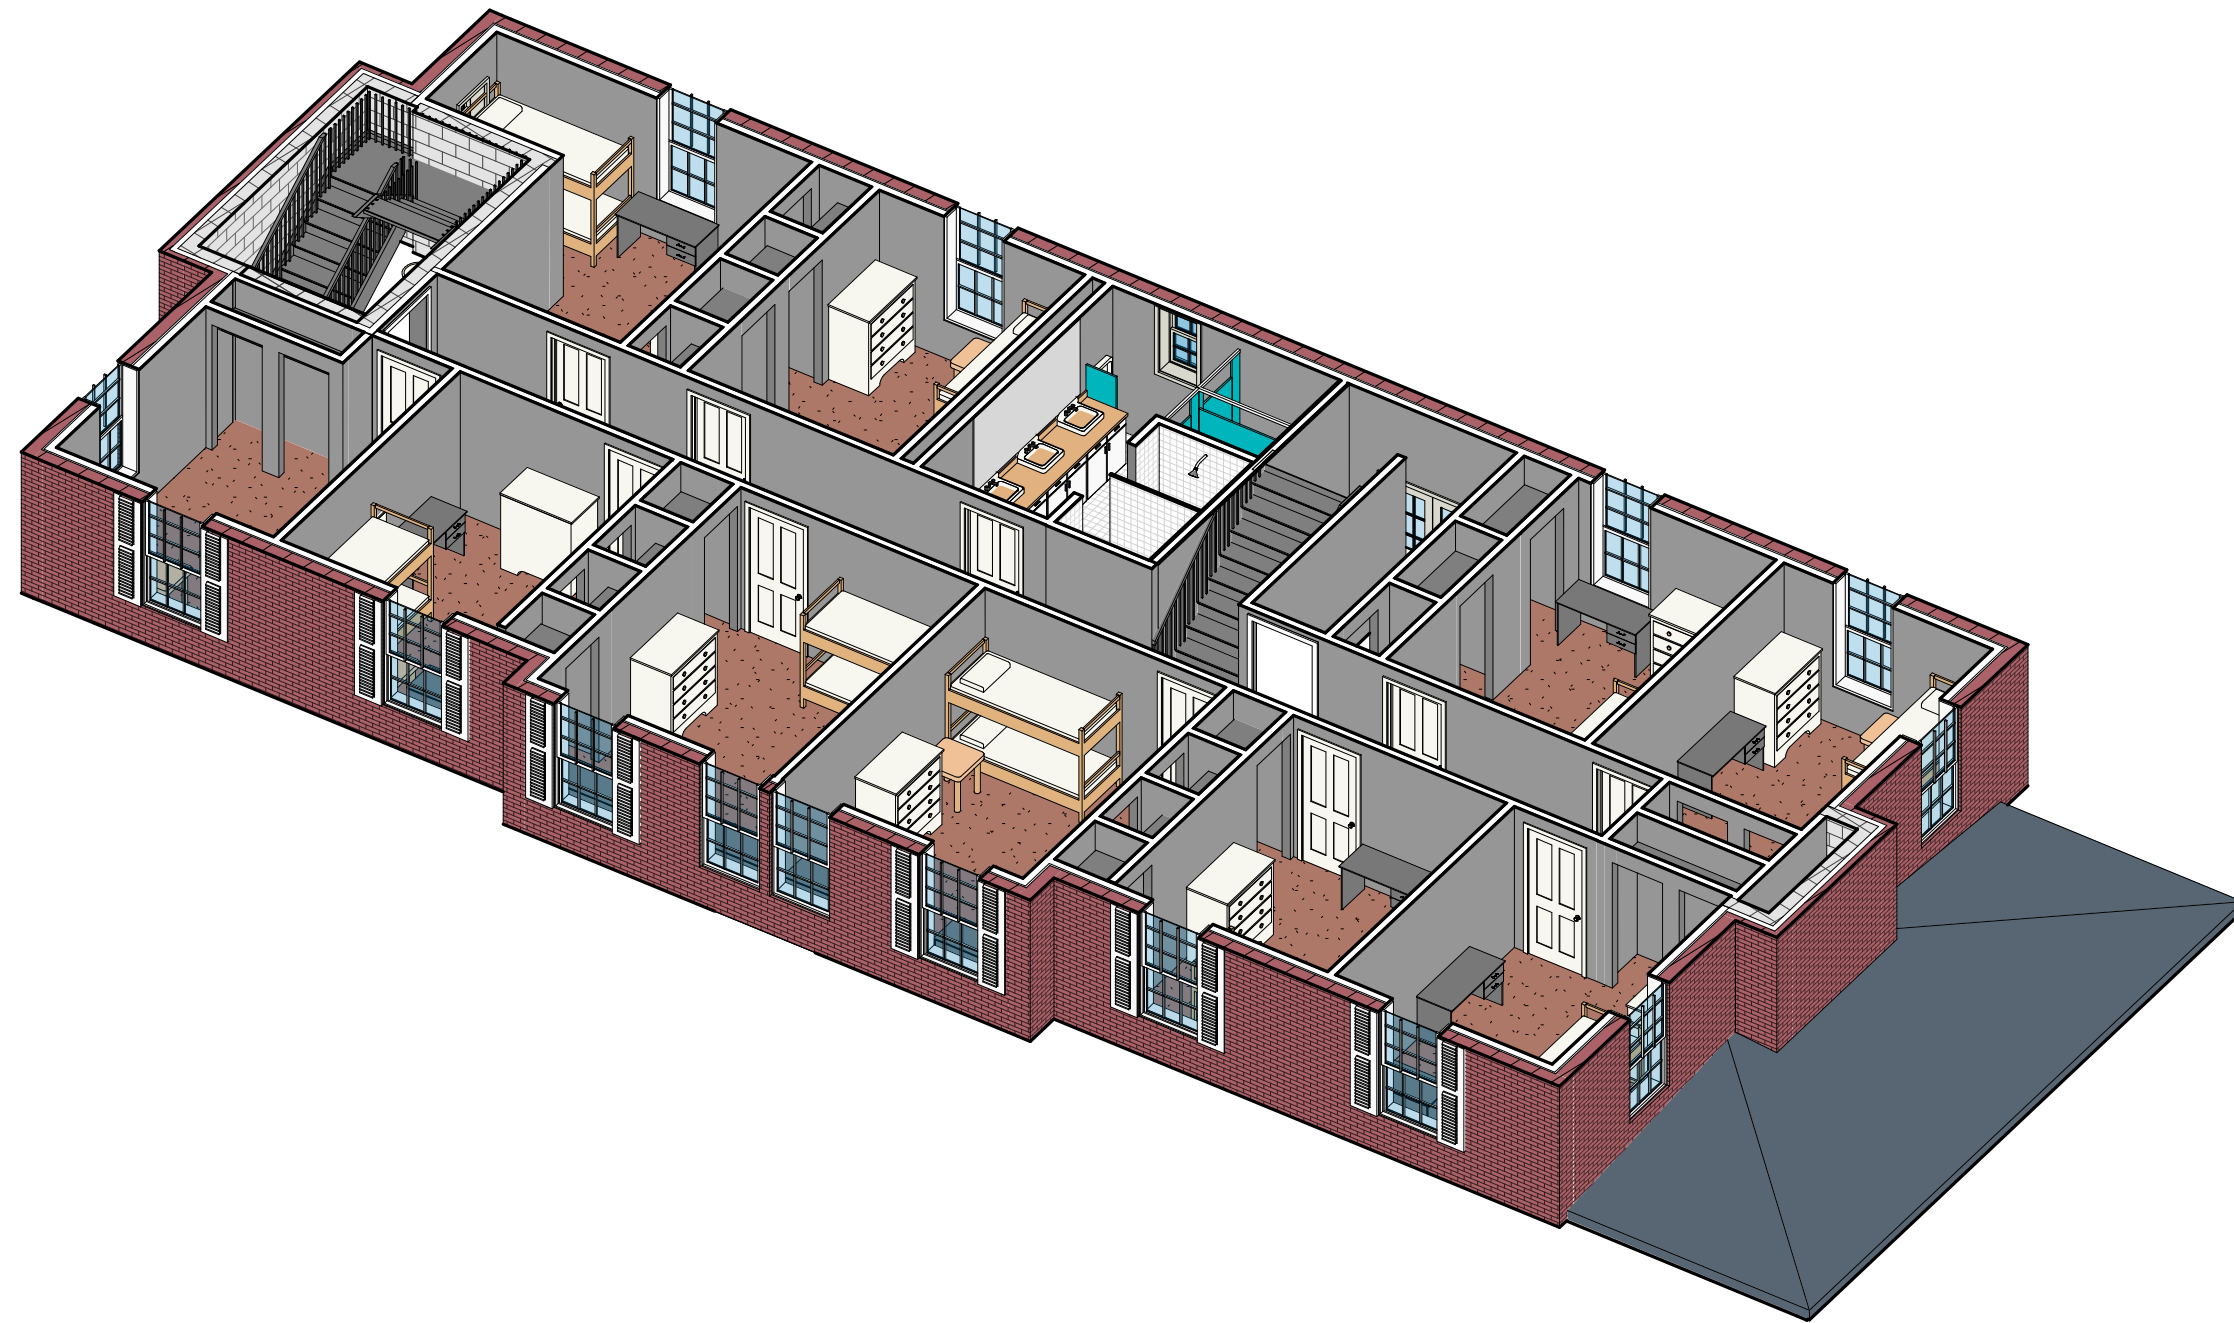


1 Dollhouse - 2nd Floor



Theta Chi of Penn State
2020 House Plan Set

| No. | Description | Date |
|-----|-------------|------|
| | | |
| | | |
| | | |
| | | |

| Dollhouse - 2nd Floor | | R201 |
|-----------------------|-------------|-------|
| Project number | ECO620 | |
| Date | 05/06/2020 | |
| Drawn by | A. SPEAGLE | |
| Checked by | A. SCHREYER | Scale |

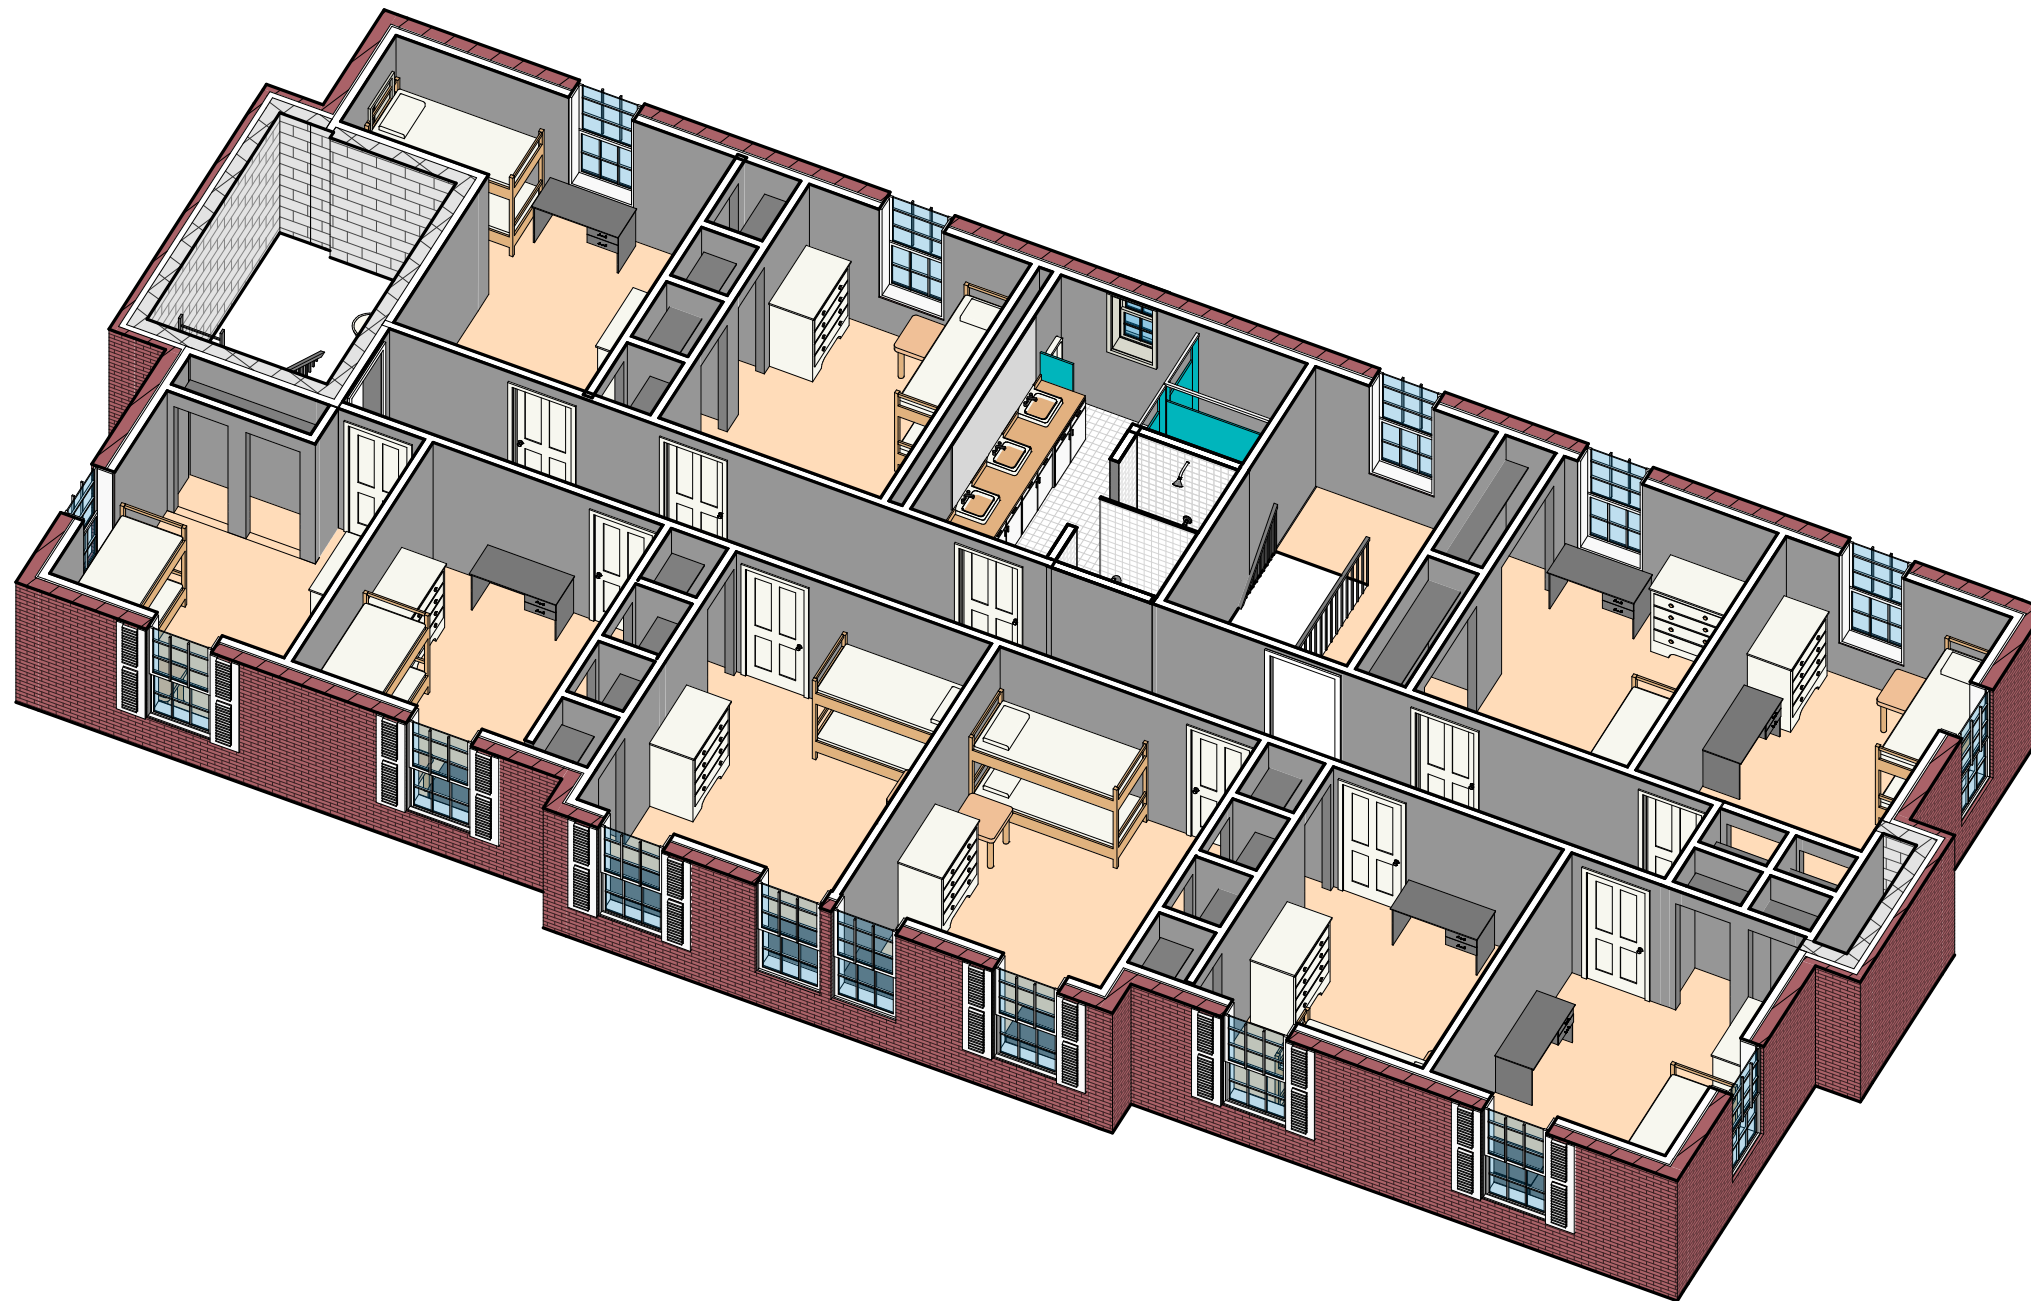


① Dollhouse - 3rd Floor



Theta Chi of Penn State
2020 House Plan Set

| No. | Description | Date |
|-----|-------------|------|
| | | |
| | | |
| | | |
| | | |

| Dollhouse - 3rd Floor | | R301 |
|-----------------------|-------------|-------|
| Project number | ECO620 | |
| Date | 05/06/2020 | |
| Drawn by | A. SPEAGLE | |
| Checked by | A. SCHREYER | Scale |

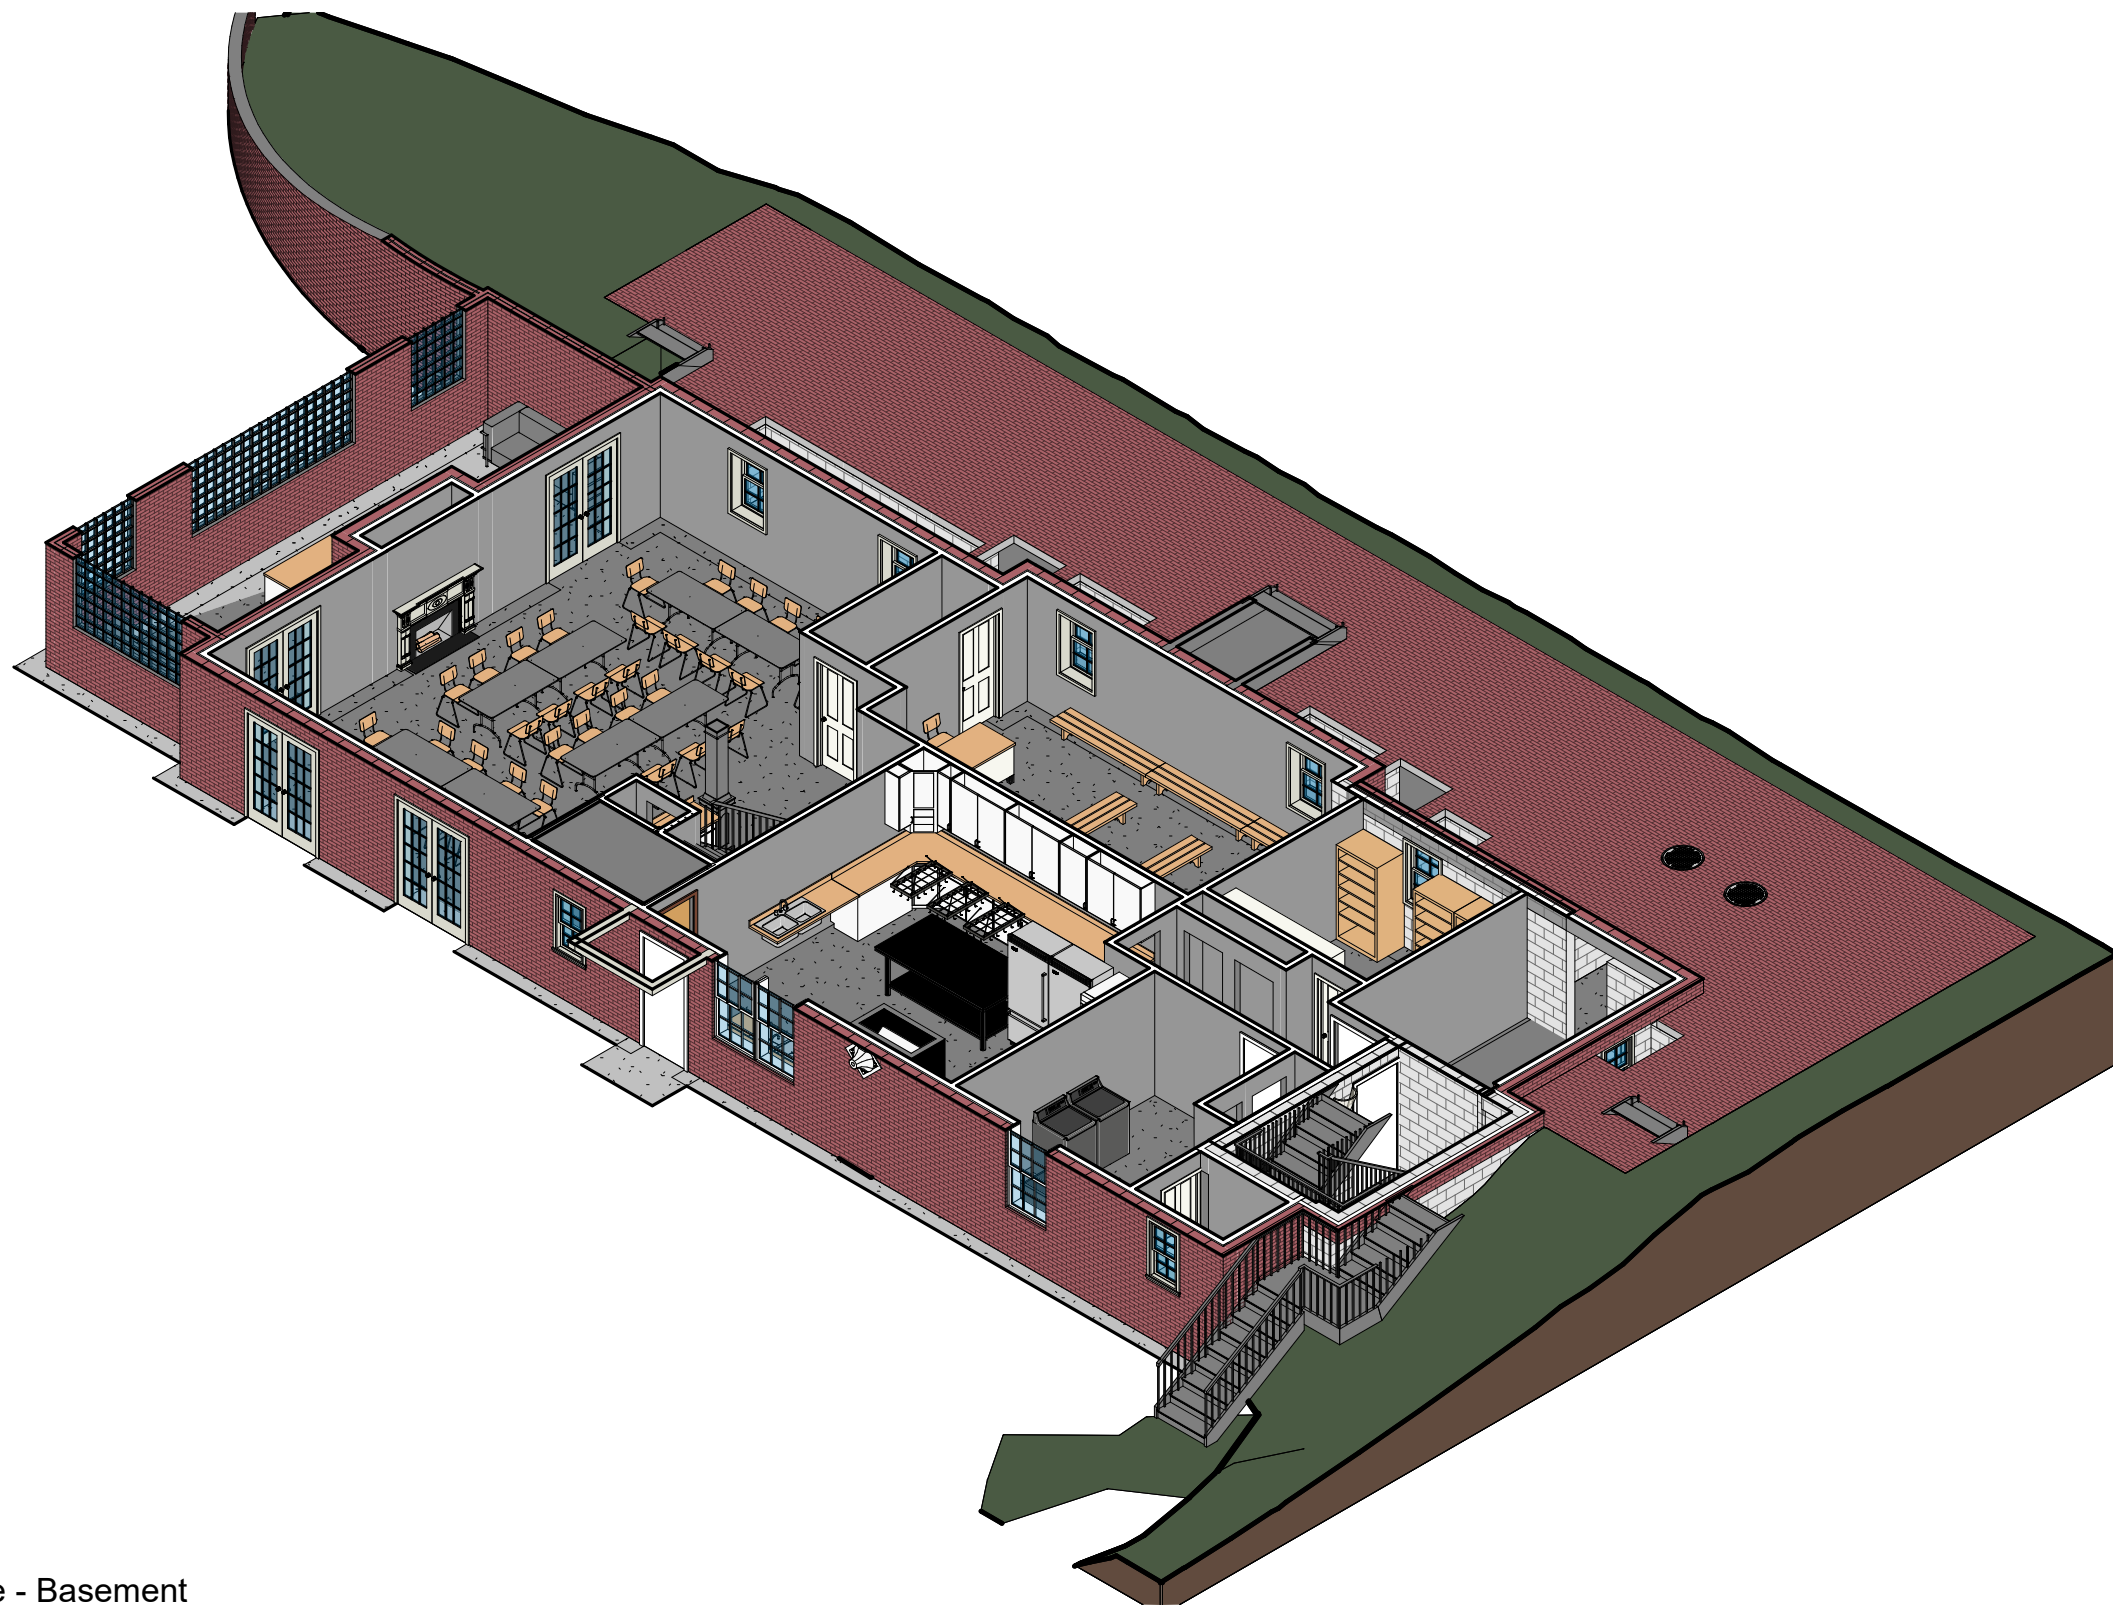

① Dollhouse - Basement



Theta Chi of Penn State
2020 House Plan Set

| No. | Description | Date |
|-----|-------------|------|
| | | |
| | | |
| | | |
| | | |

| Dollhouse - Basement | | RB01 |
|----------------------|-------------|-------|
| Project number | ECO620 | |
| Date | 05/06/2020 | |
| Drawn by | A. SPEAGLE | |
| Checked by | A. SCHREYER | Scale |





① Camera - Kitchen



Theta Chi of Penn State
2020 House Plan Set

| No. | Description | Date |
|-----|-------------|------|
| | | |
| | | |
| | | |
| | | |

| Camera - Kitchen As-Built | | |
|---------------------------|-------------|-------------|
| Project number | ECO620 | RB03 |
| Date | 05/06/2020 | |
| Drawn by | A. SPEAGLE | |
| Checked by | A. SCHREYER | |
| Scale | | |

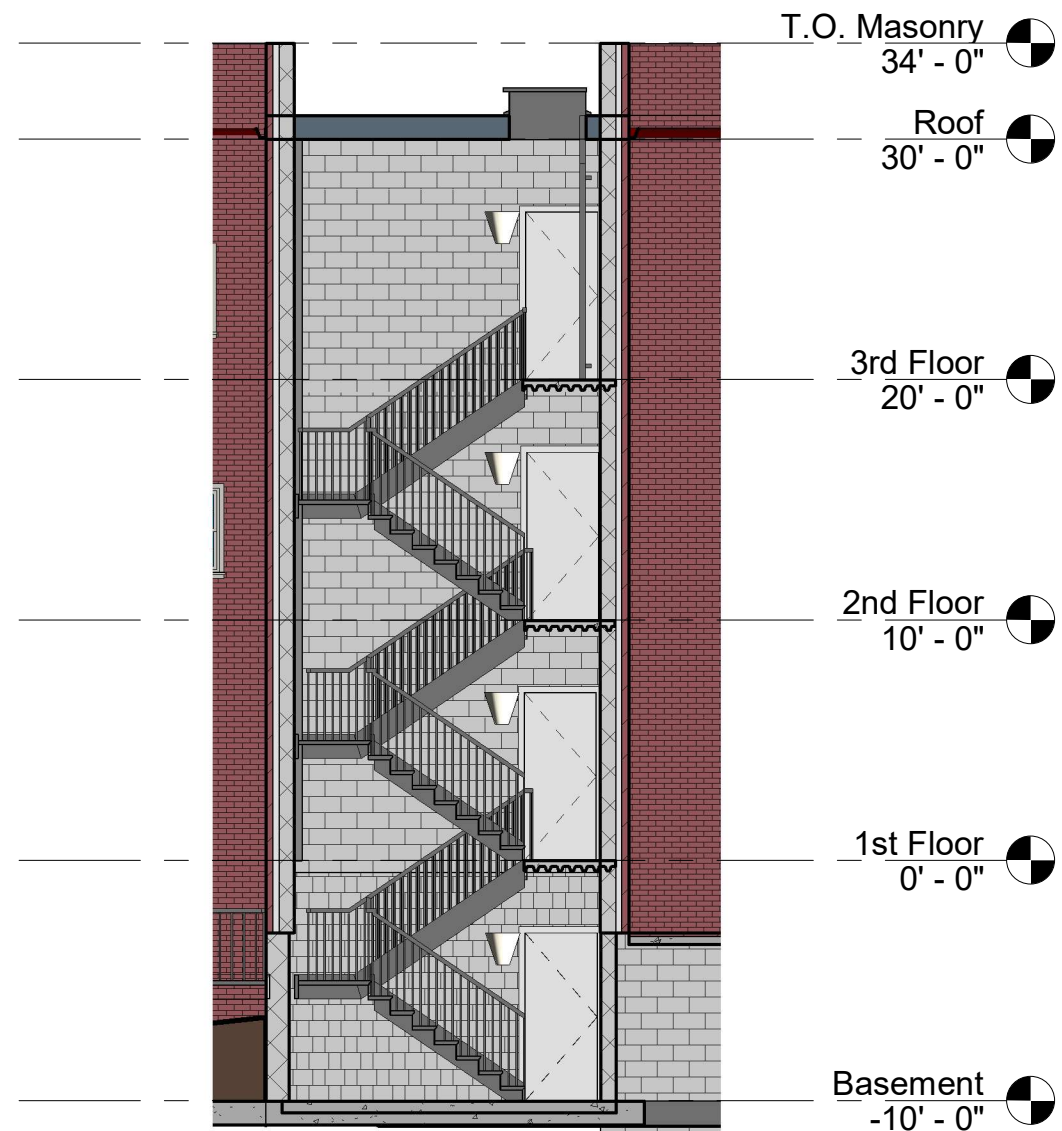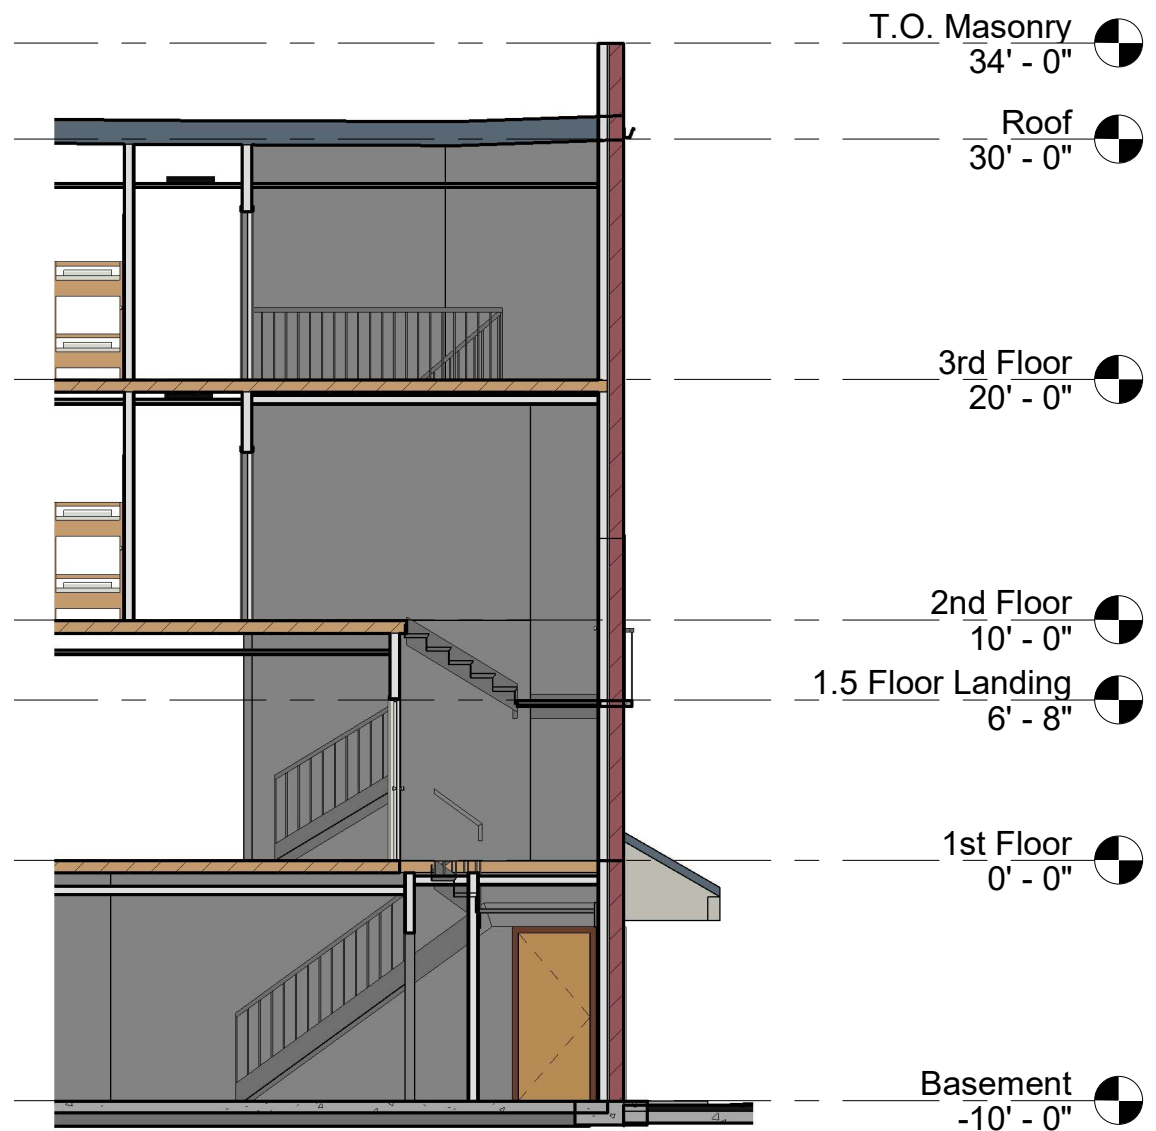

① Main Stair
1/8" = 1'-0"

② Fire Stair
1/8" = 1'-0"



Theta Chi of Penn State
2020 House Plan Set

| No. | Description | Date |
|-----|-------------|------|
| | | |
| | | |
| | | |
| | | |

| Section - Stairwells | | |
|----------------------|-------------|--------------|
| Project number | ECO620 | S001 |
| Date | 05/06/2020 | |
| Drawn by | A. SPEAGLE | |
| Checked by | A. SCHREYER | |
| Scale | | 1/8" = 1'-0" |




① Rear Section
1/8" = 1'-0"



Theta Chi of Penn State
2020 House Plan Set

| No. | Description | Date |
|-----|-------------|------|
| | | |
| | | |
| | | |
| | | |

| Section - Looking North | | |
|-------------------------|-------------|--------------------|
| Project number | ECO620 | S002 |
| Date | 05/06/2020 | |
| Drawn by | A. SPEAGLE | |
| Checked by | A. SCHREYER | |
| | | Scale 1/8" = 1'-0" |

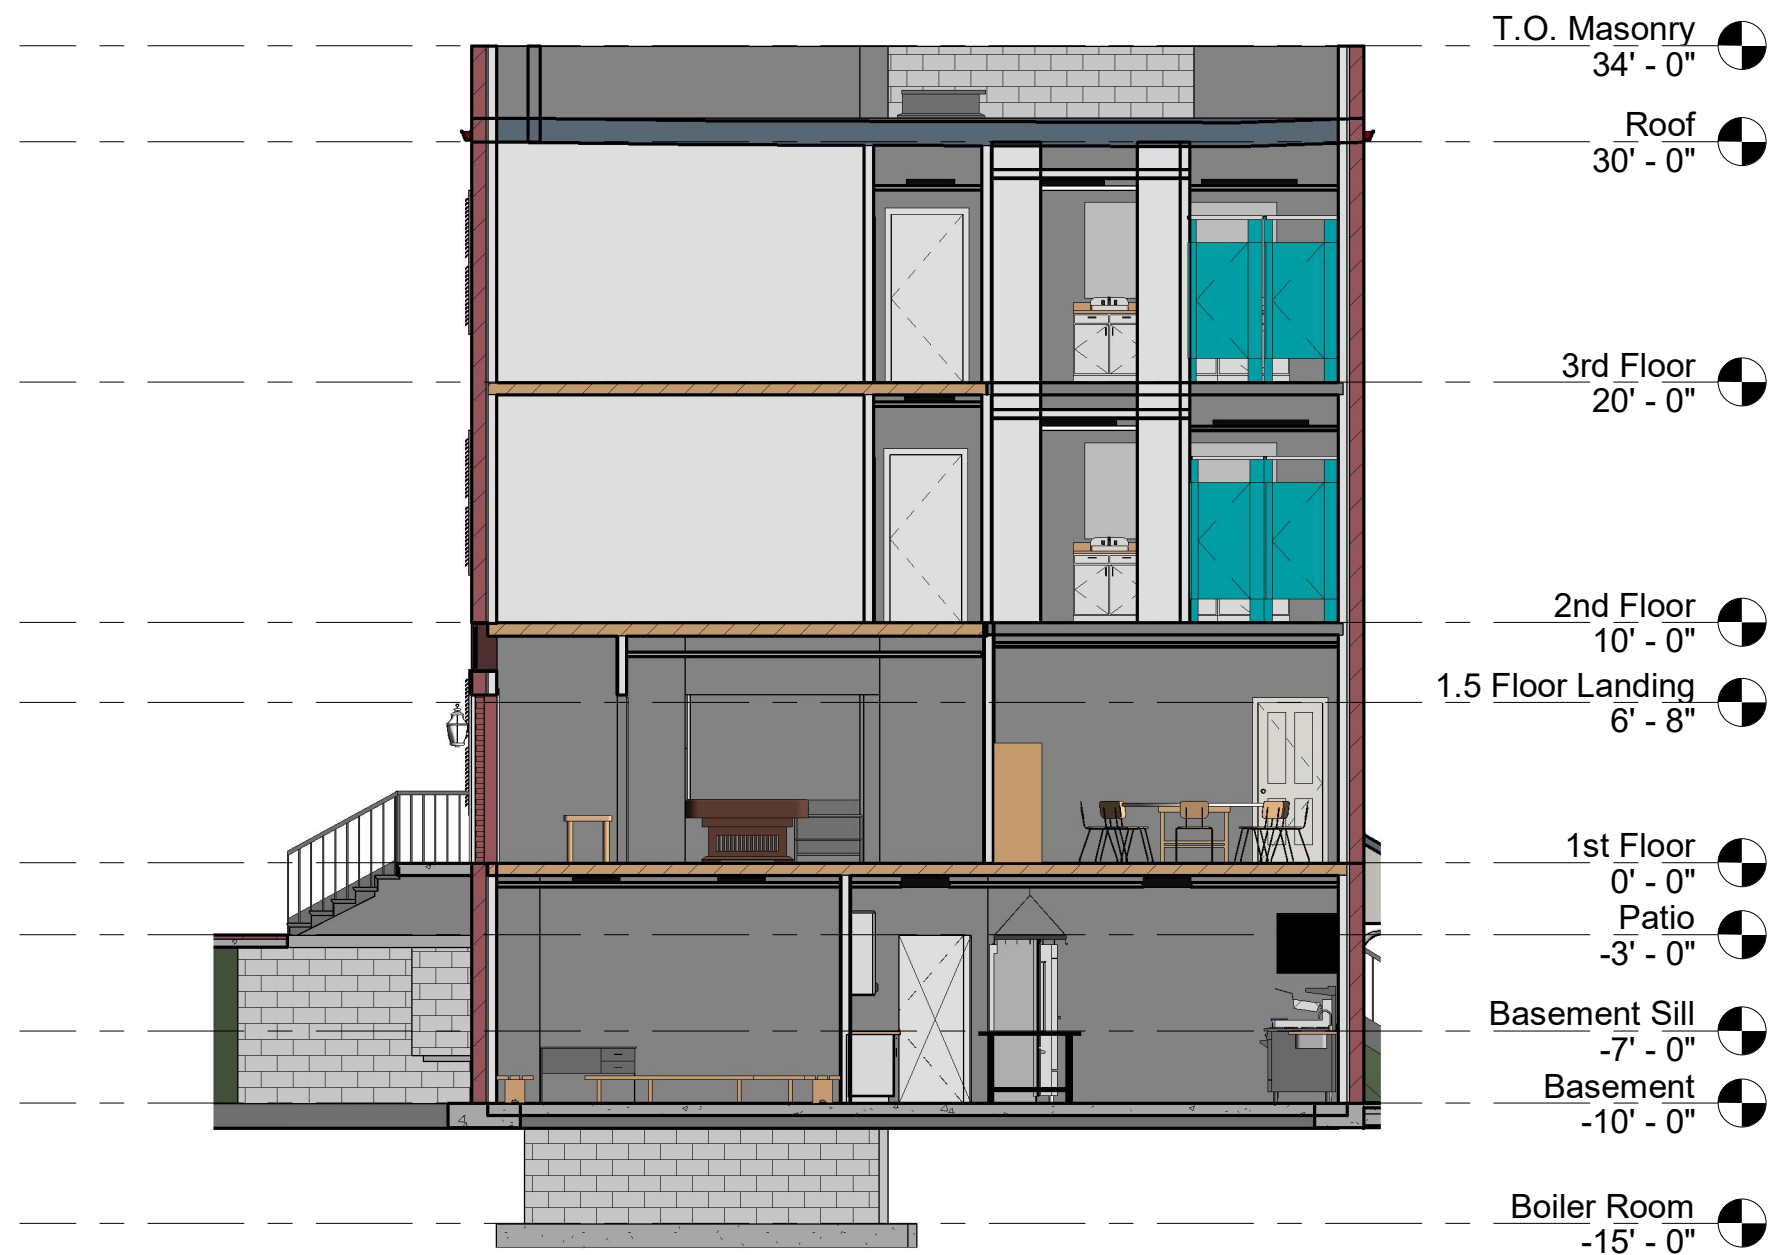

① Centerline - Facing Phi Sig
1/8" = 1'-0"




Theta Chi of Penn State 2020 House Plan Set


| No. | Description | Date |
|-----|-------------|------|
| | | |
| | | |
| | | |
| | | |

Section - Looking West


| | | |
|----------------|-------------|--------------|
| Project number | ECO620 | S003 |
| Date | 05/06/2020 | |
| Drawn by | A. SPEAGLE | |
| Checked by | A. SCHREYER | |
| Scale | | 1/8" = 1'-0" |

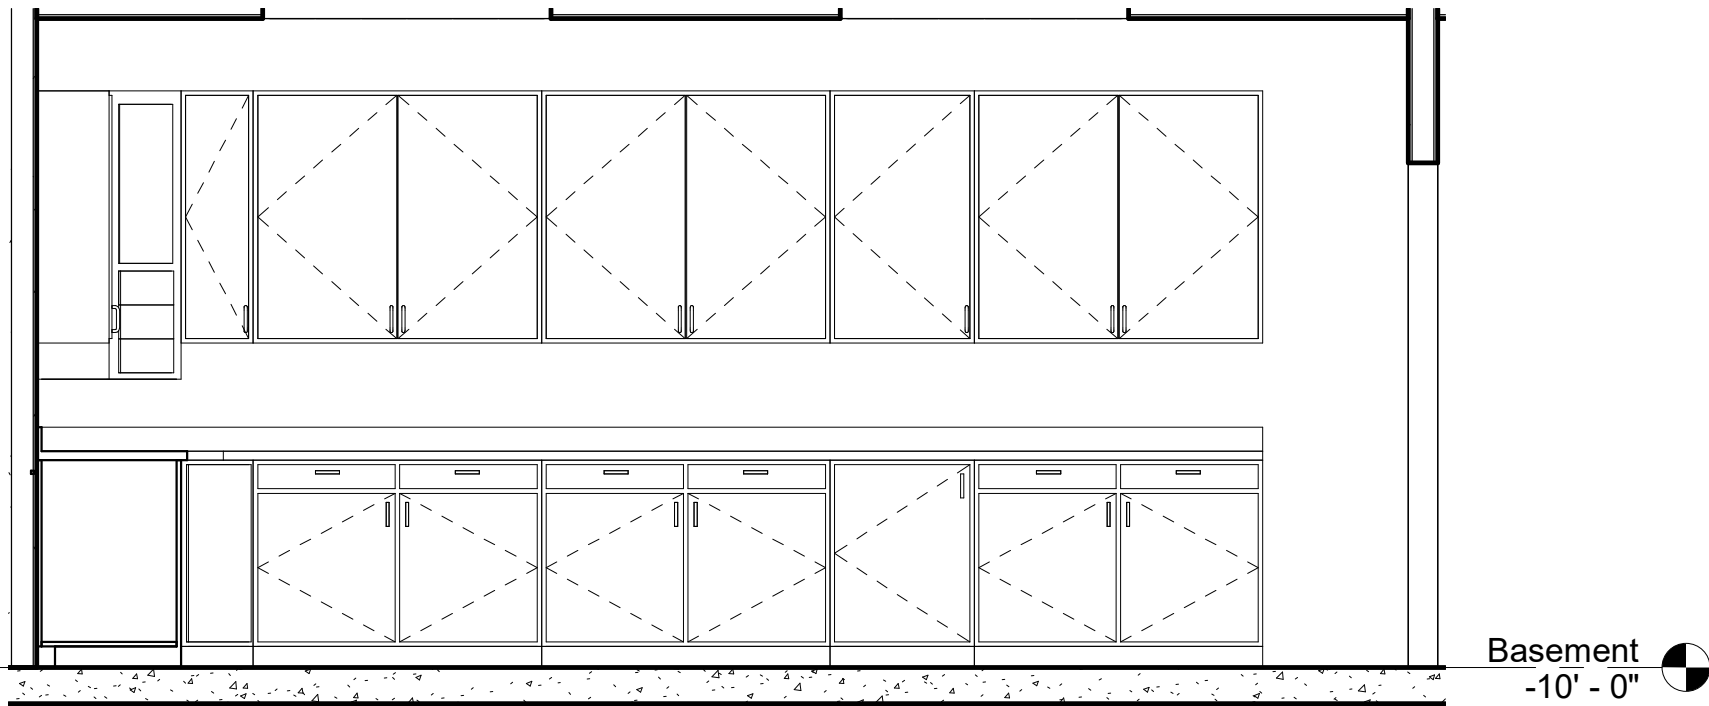

1 Kitchen Counters (Rear)
3/8" = 1'-0"

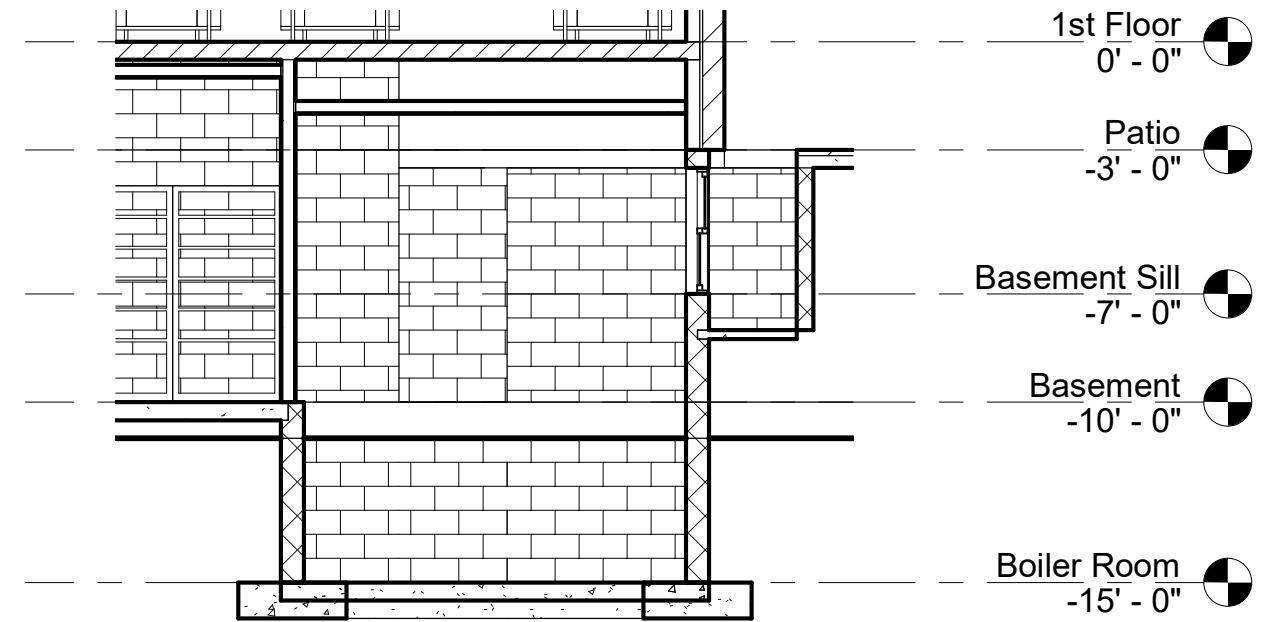

3 Boiler Room Looking Front
3/16" = 1'-0"

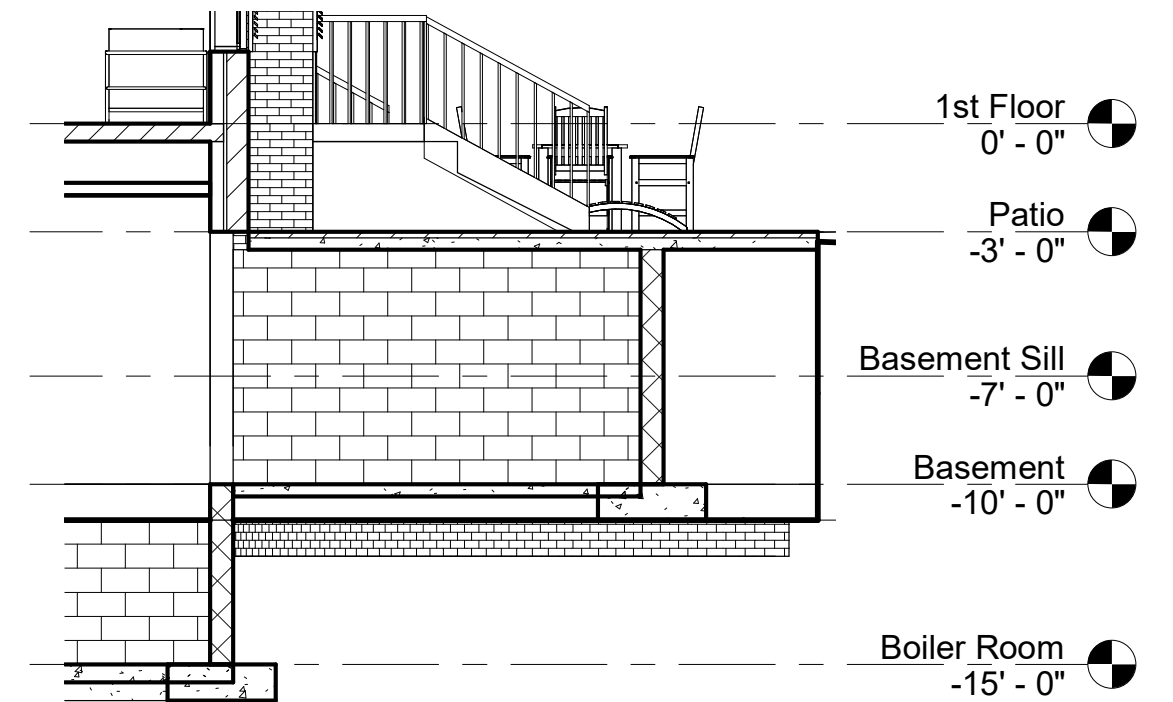

2 Boiler/Coal Storage
3/16" = 1'-0"




Theta Chi of Penn State
2020 House Plan Set


| No. | Description | Date |
|-----|-------------|------|
| | | |
| | | |
| | | |
| | | |

Detail - Basement

| | | |
|--------------------|-------------|-------------|
| Project number | ECO620 | DB01 |
| Date | 05/06/2020 | |
| Drawn by | A. SPEAGLE | |
| Checked by | A. SCHREYER | |
| Scale As indicated | | |

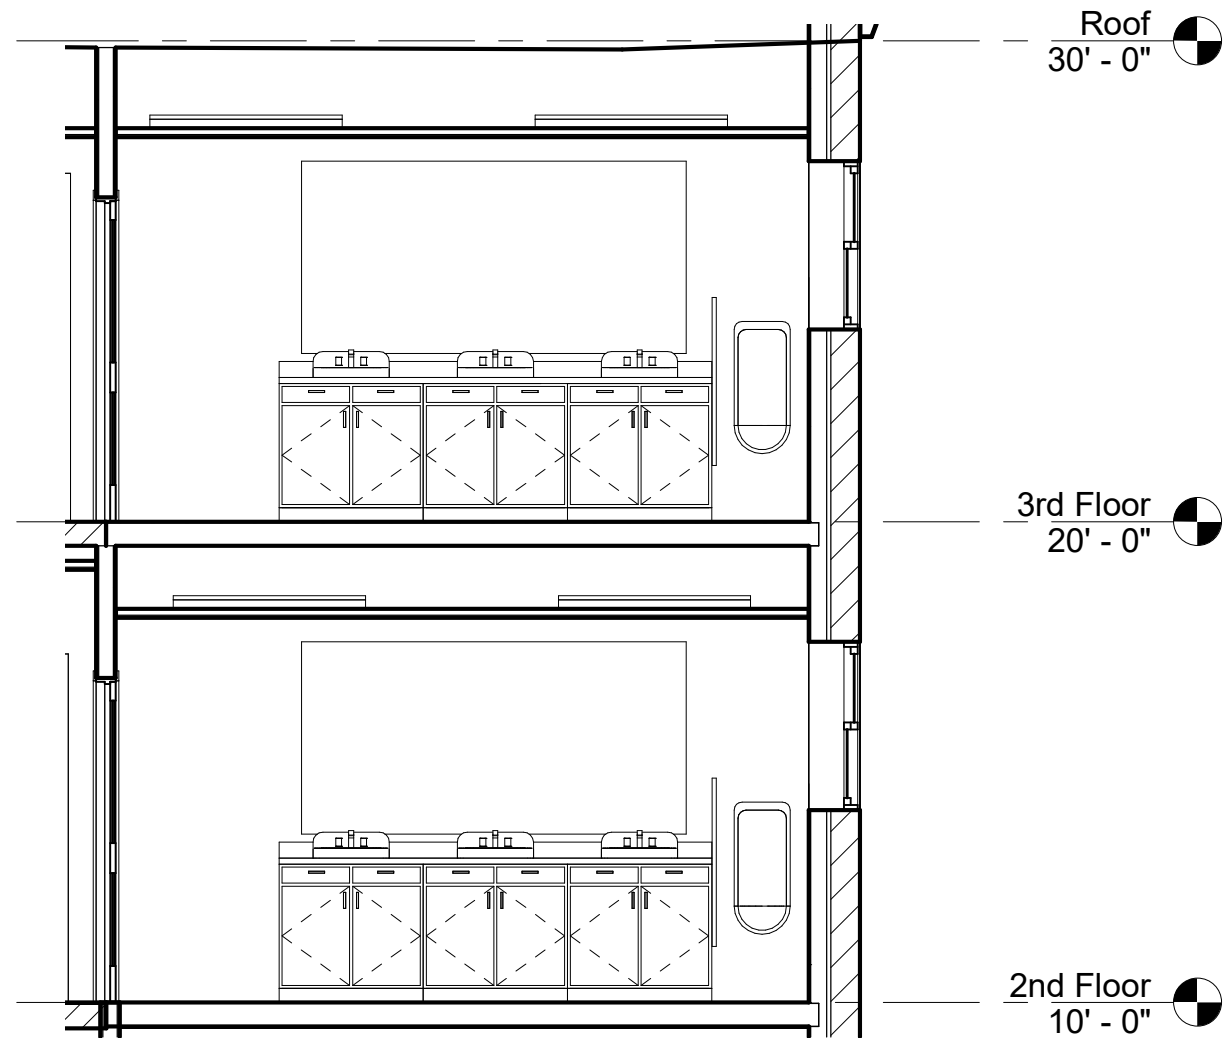

① Detail - Bath Sinks
1/4" = 1'-0"

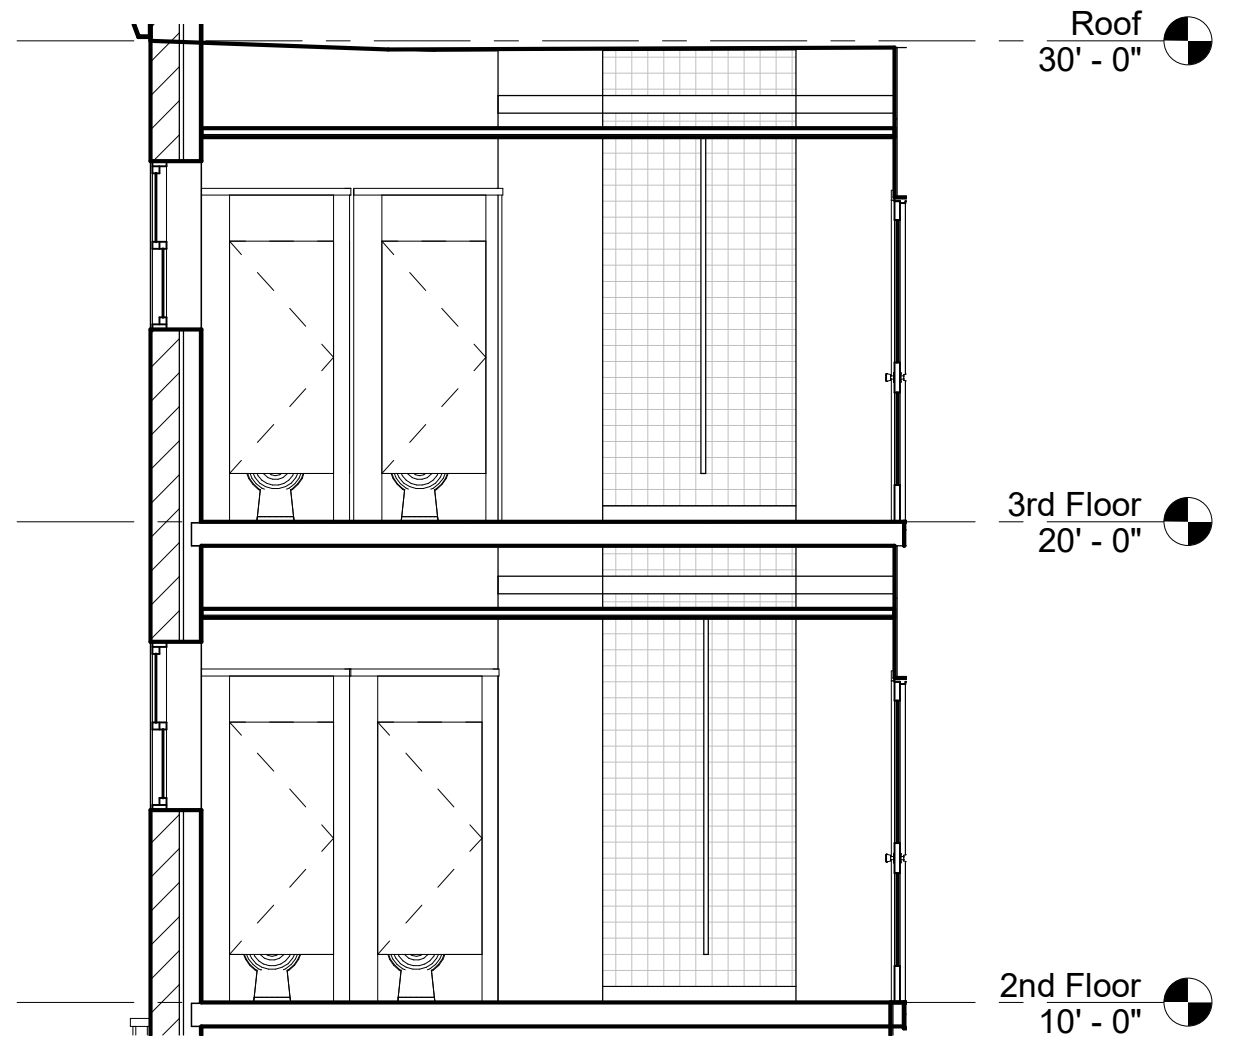

② Detail - Shower & stalls
1/4" = 1'-0"



Theta Chi of Penn State
2020 House Plan Set

| No. | Description | Date |
|-----|-------------|------|
| | | |
| | | |
| | | |
| | | |

| Detail - 2nd & 3rd Floor Bath | | |
|-------------------------------|-------------|--------------|
| Project number | ECO620 | D001 |
| Date | 05/06/2020 | |
| Drawn by | A. SPEAGLE | |
| Checked by | A. SCHREYER | |
| Scale | | 1/4" = 1'-0" |